


T. 14 S., R. 11 E., W. M.

RECEIVED
MAY 1999

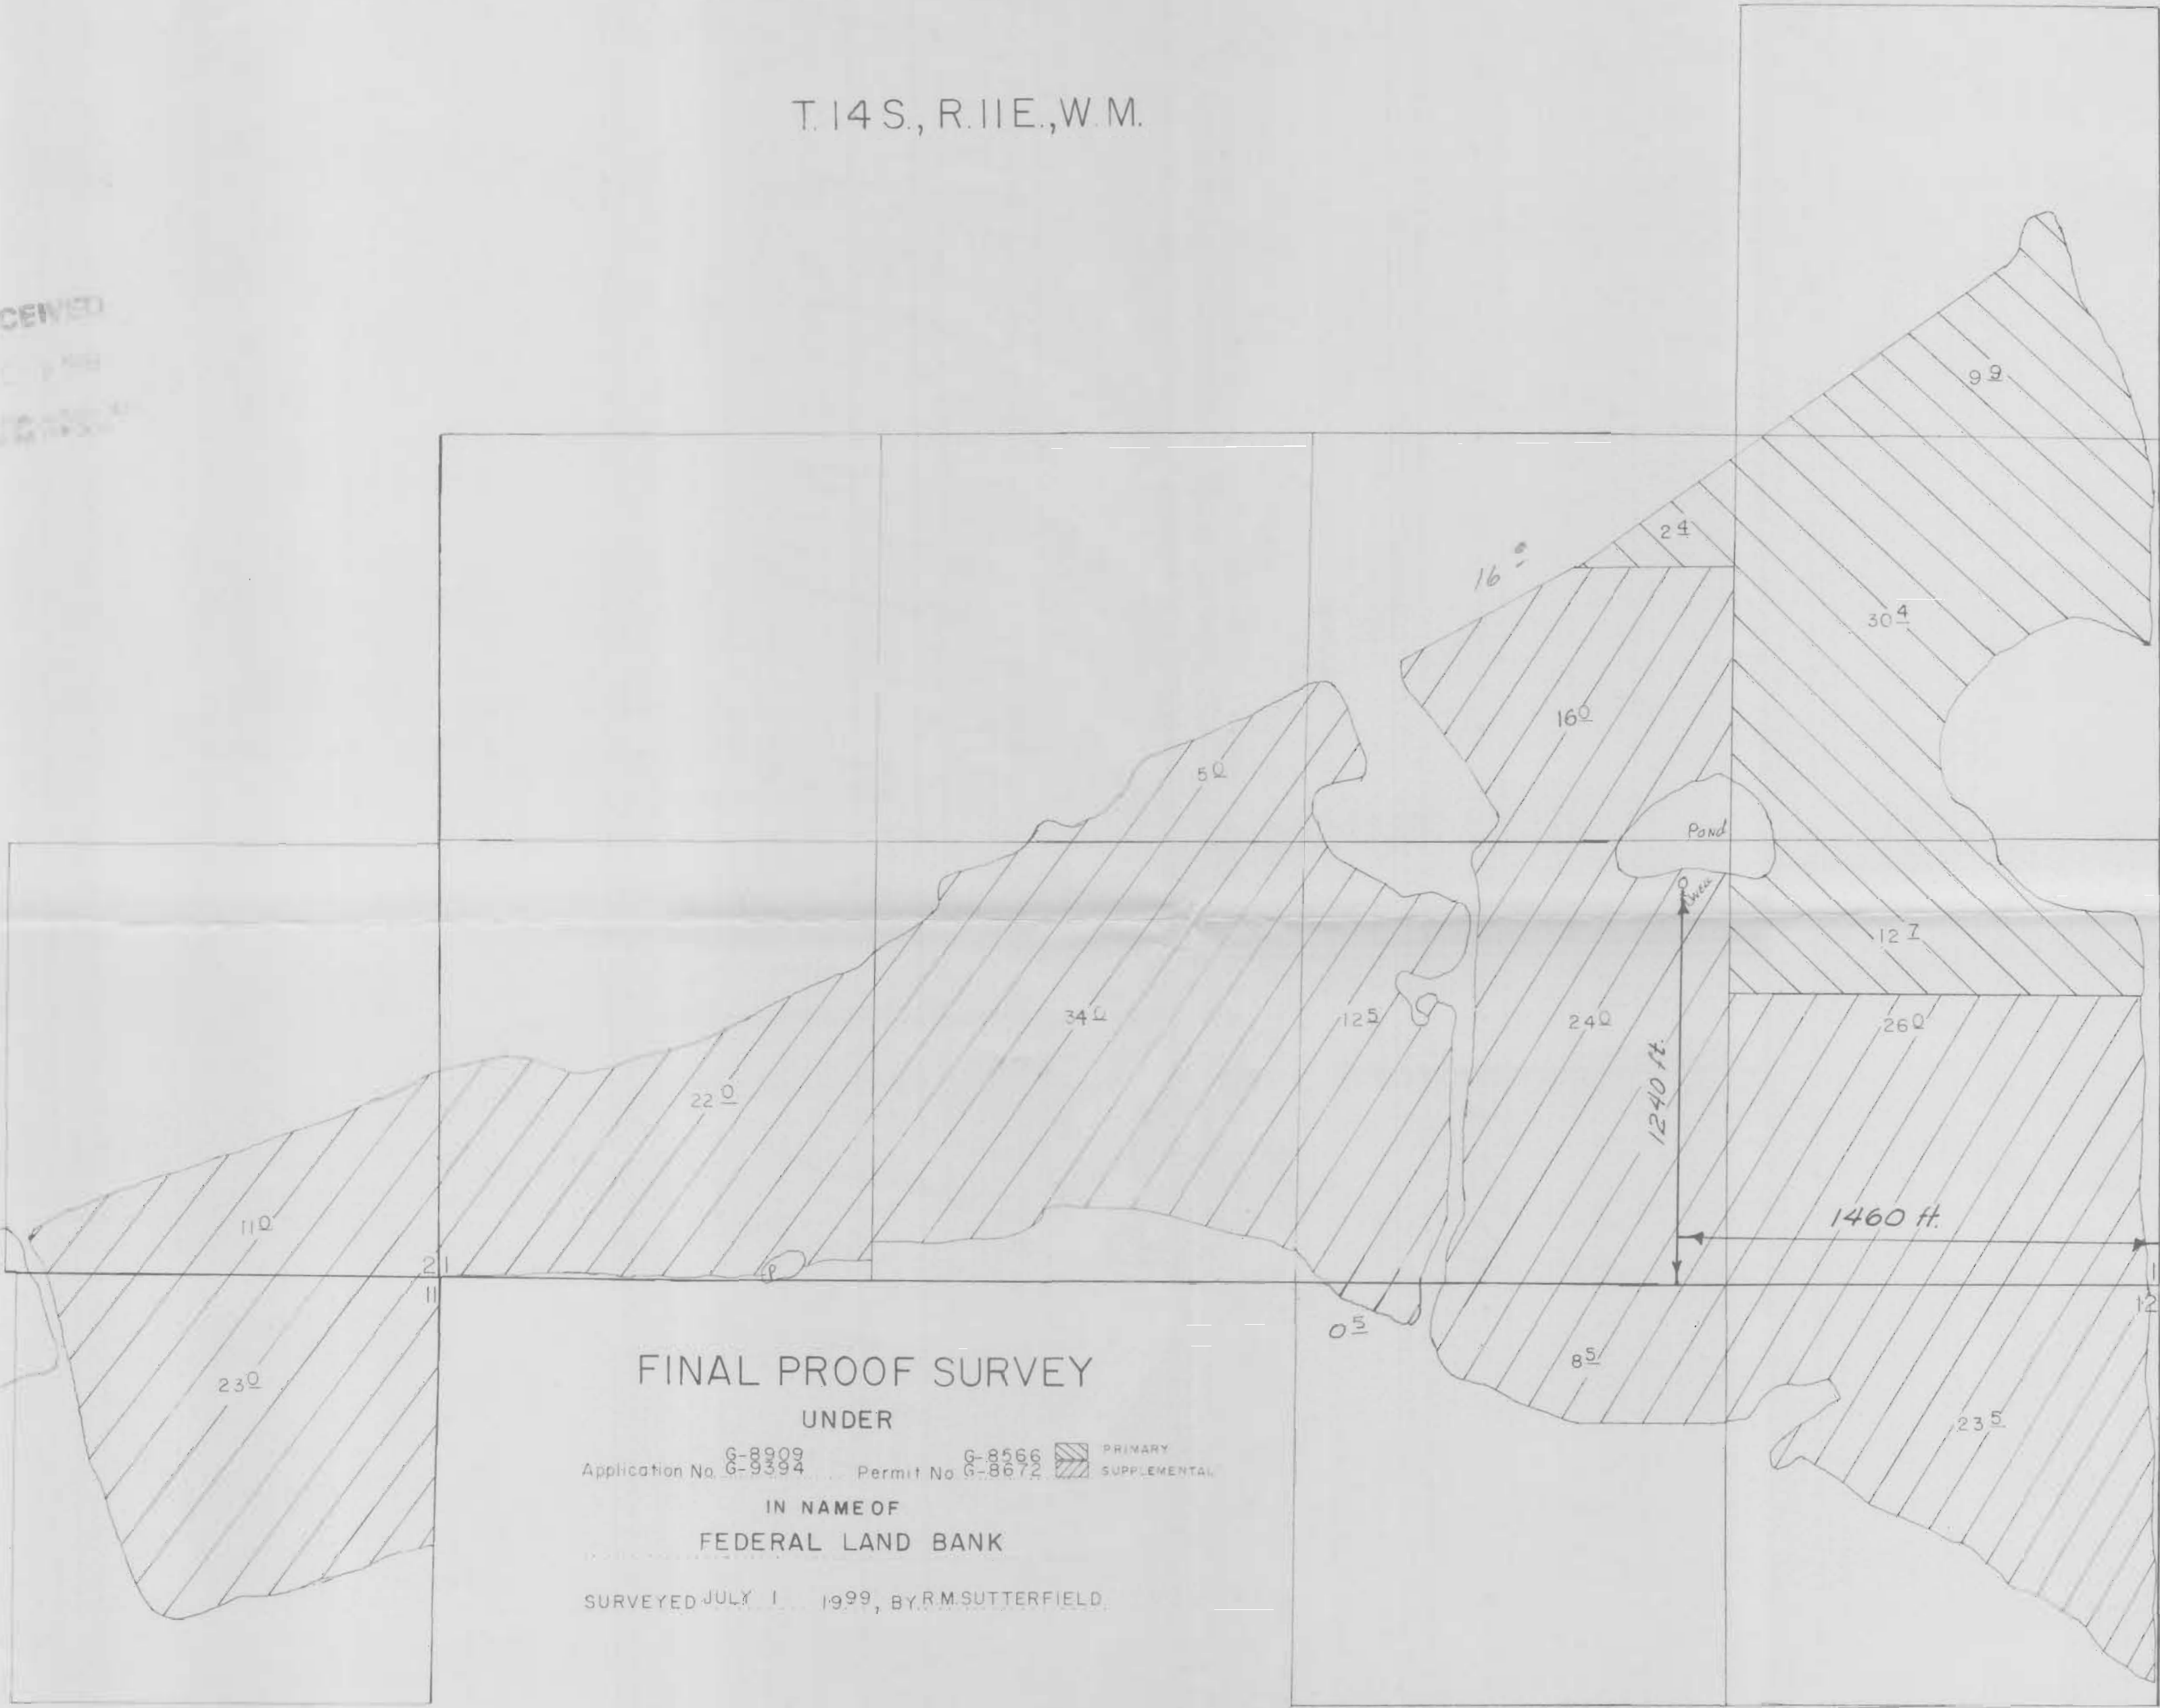

FINAL PROOF SURVEY

UNDER


PRIMARY
SUPPLEMENTAL

IN NAME OF
FEDERAL LAND BANK

SURVEYED JULY 1, 1999, BY R.M. SUTTERFIELD.

Revised 5/8/2000 *[Signature]*