T. 14 S., R. 11 E., W. M.

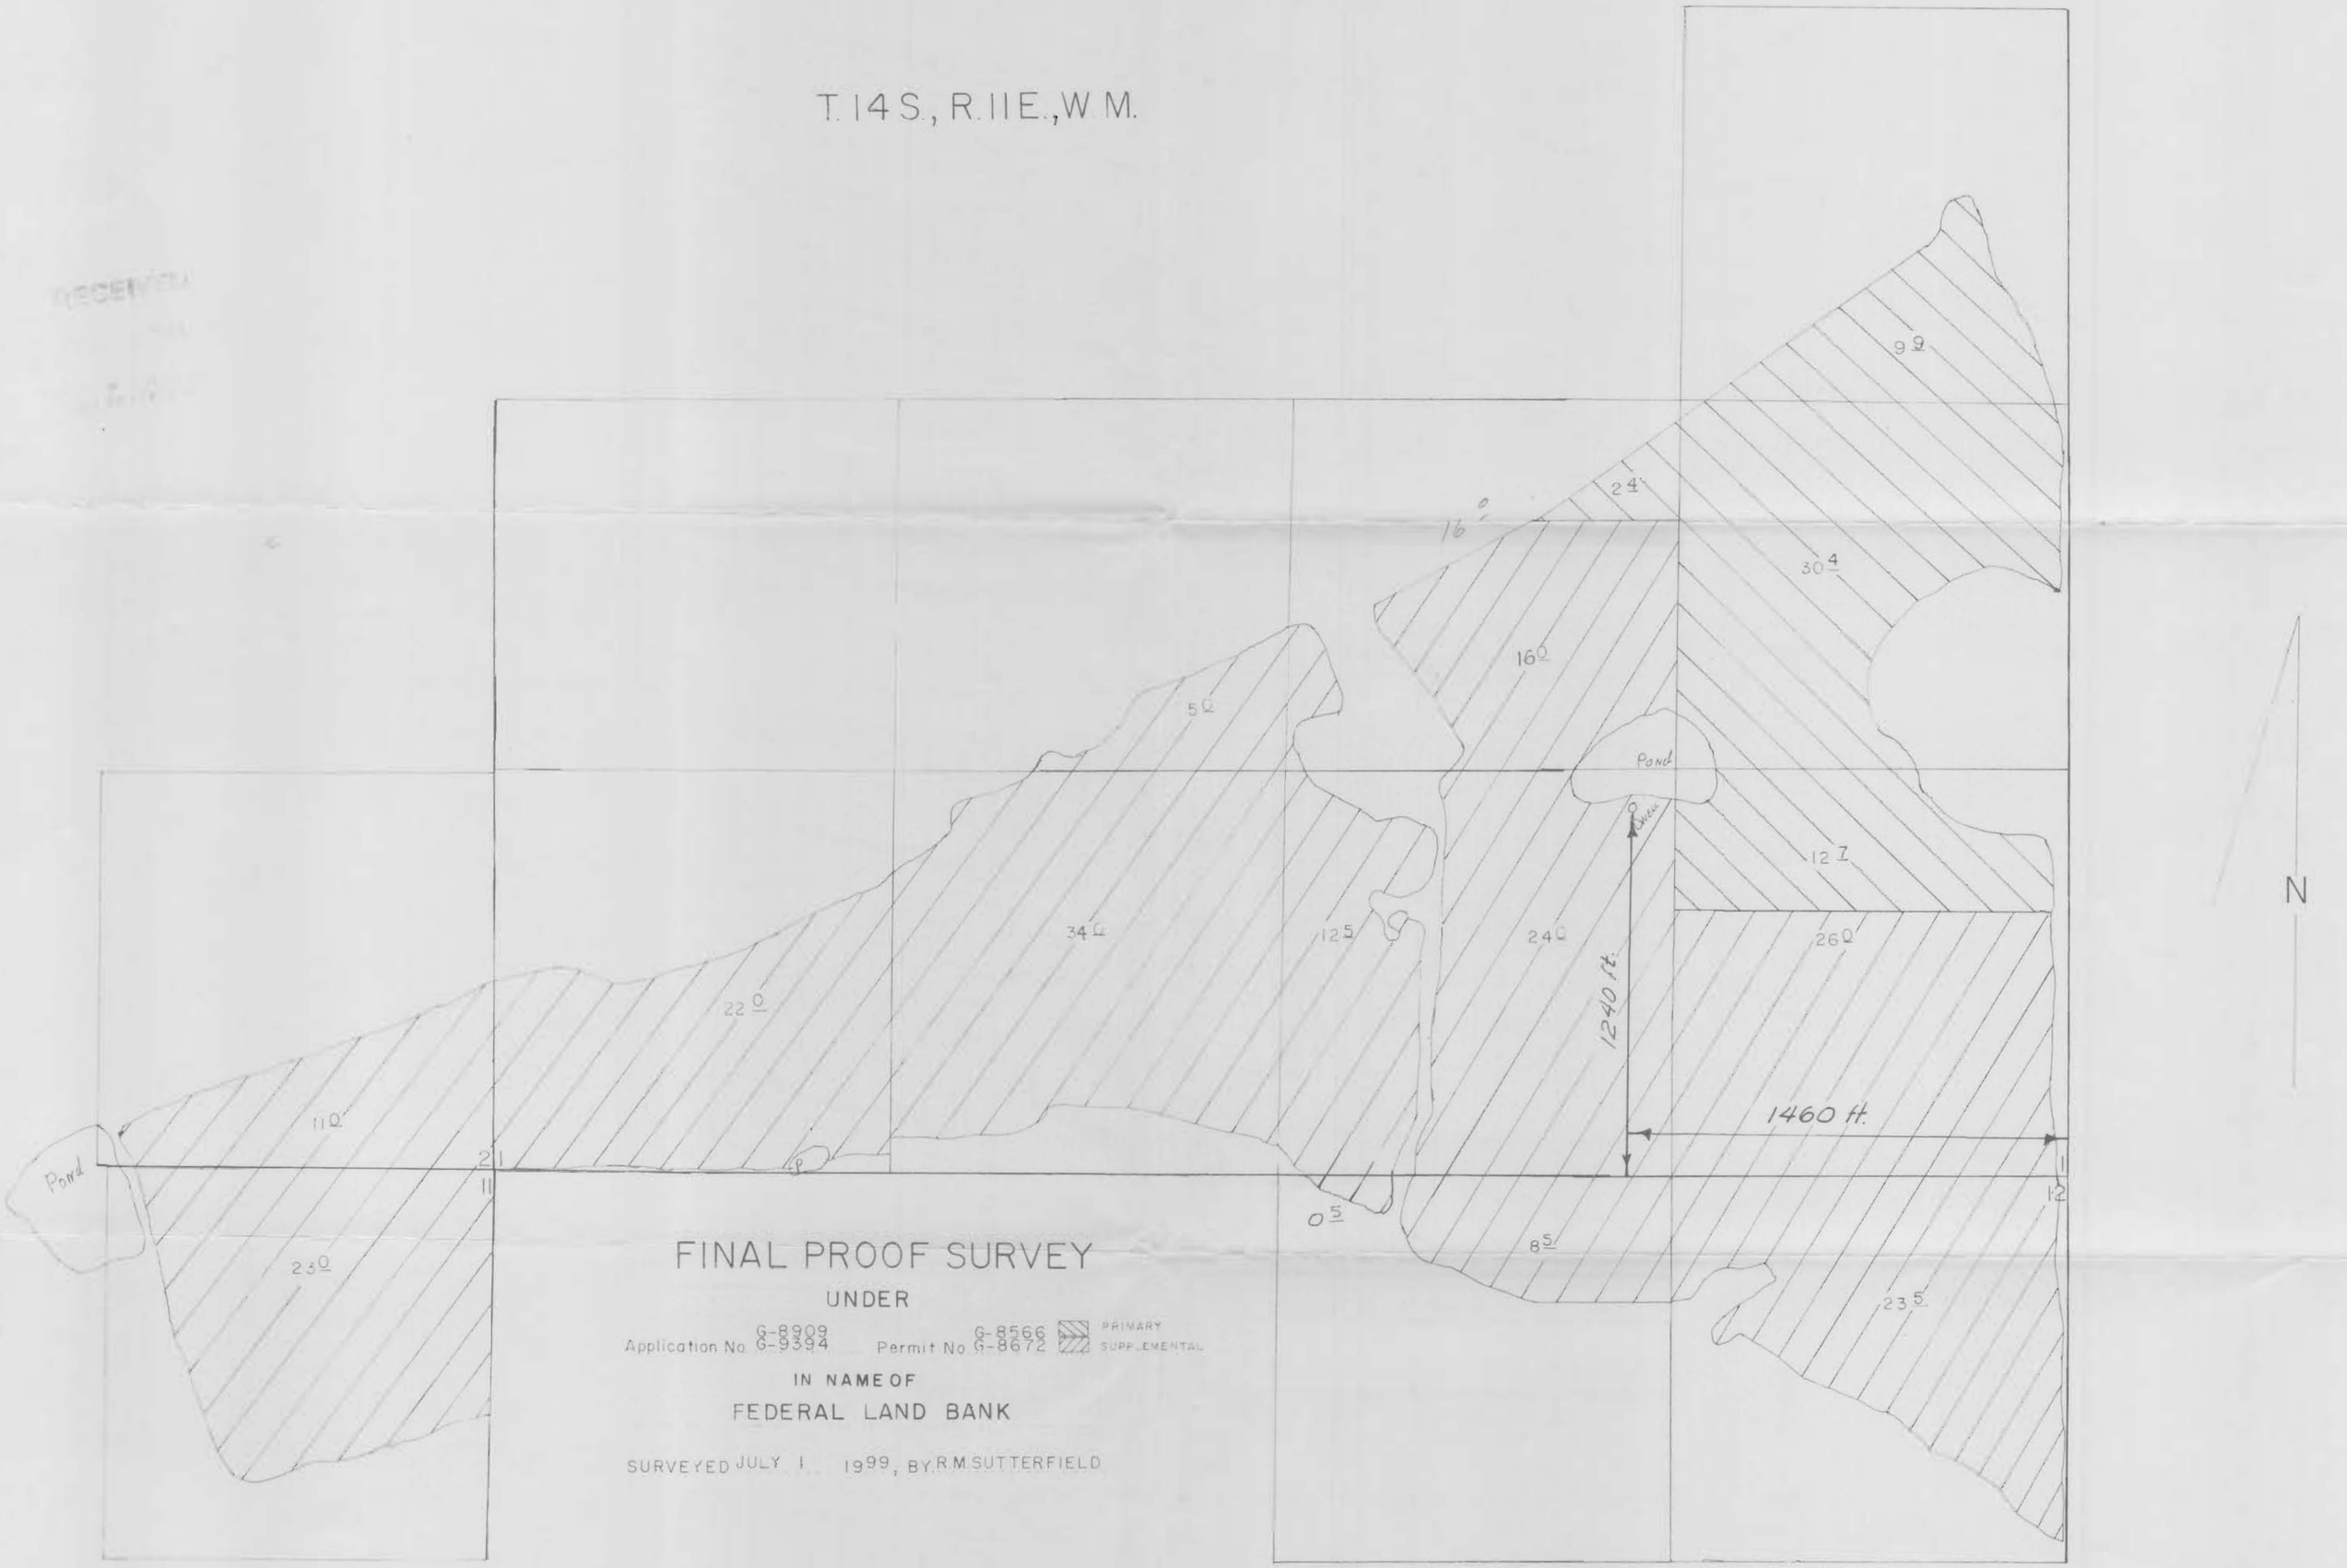

FINAL PROOF SURVEY

UNDER

Application No. G-8909 G-9394 Permit No. G-8566 G-8672 PRIMARY SUPPLEMENTAL

IN NAME OF

FEDERAL LAND BANK

SURVEYED JULY 1 1999, BY R.M. SUTTERFIELD

Revised 5/8/2000