


T. 6N. R. 35E.W.M.

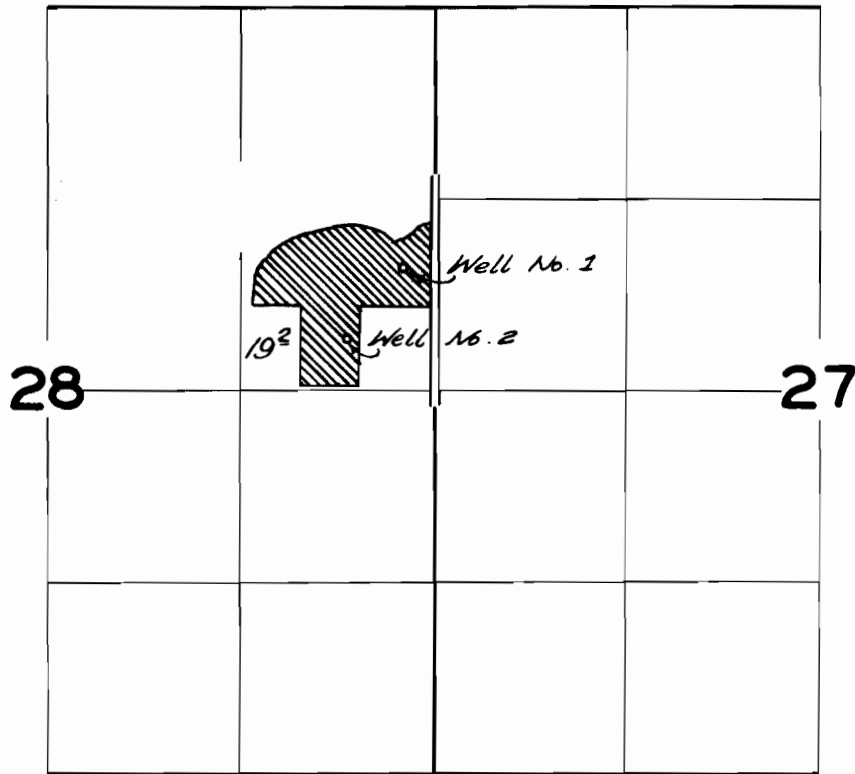

FINAL PROOF SURVEY

UNDER

Application No. G-972 Permit No. G-864

IN NAME OF

Walter J. Rand

Surveyed Oct 28 1959, by C.O. Burtels