


T.4&5S.R.4W.W.M.

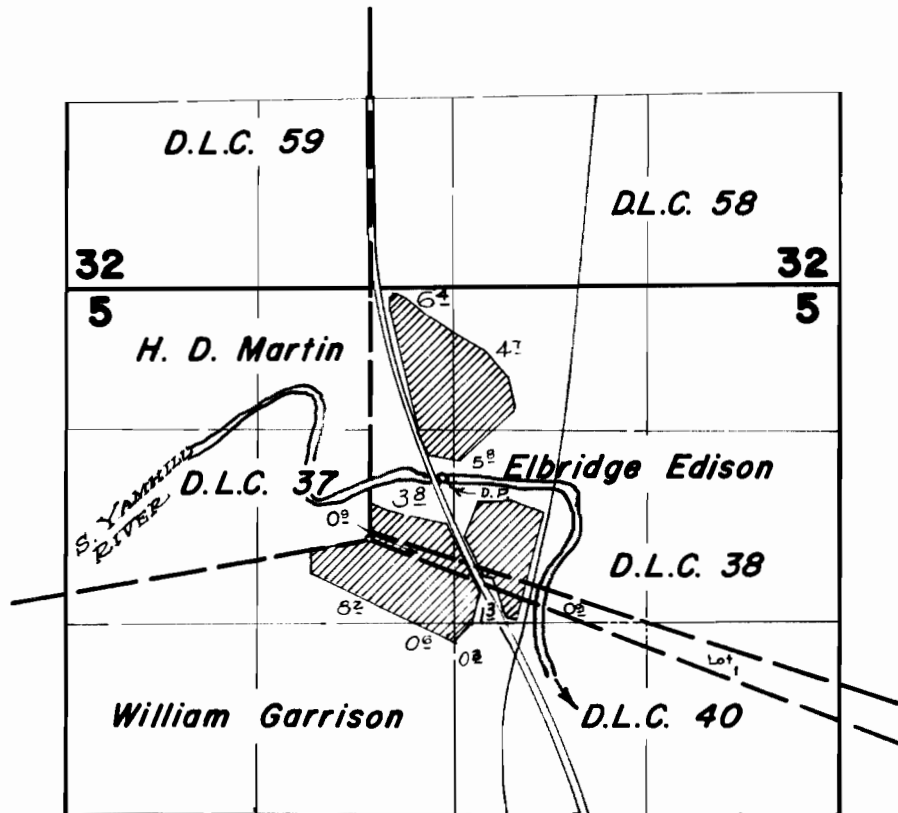

FINAL PROOF SURVEY
UNDER

Application No. 18050 Permit No. 13718
IN NAME OF

J. S. TRESHAM

Surveyed April 26, 1941, by C. A. Cummings

