

Klamath Riv. Misc.
 Tax lot 1101
 SECTION 28 T.40S. R.08E. W.M.
 KLAMATH COUNTY


40 08 28

40 8 28

THIS MAP WAS PREPARED FOR
 ASSESSMENT PURPOSE ONLY.

SEE MAP 40 08 21C

SEE MAP 40 08 21

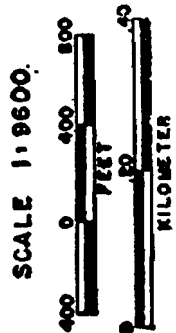


WATER RESOURCES DEPT.
 SALEM, OREGON

JAN 27 2007

RECEIVED

RECEIVED
 MAR 12 1996

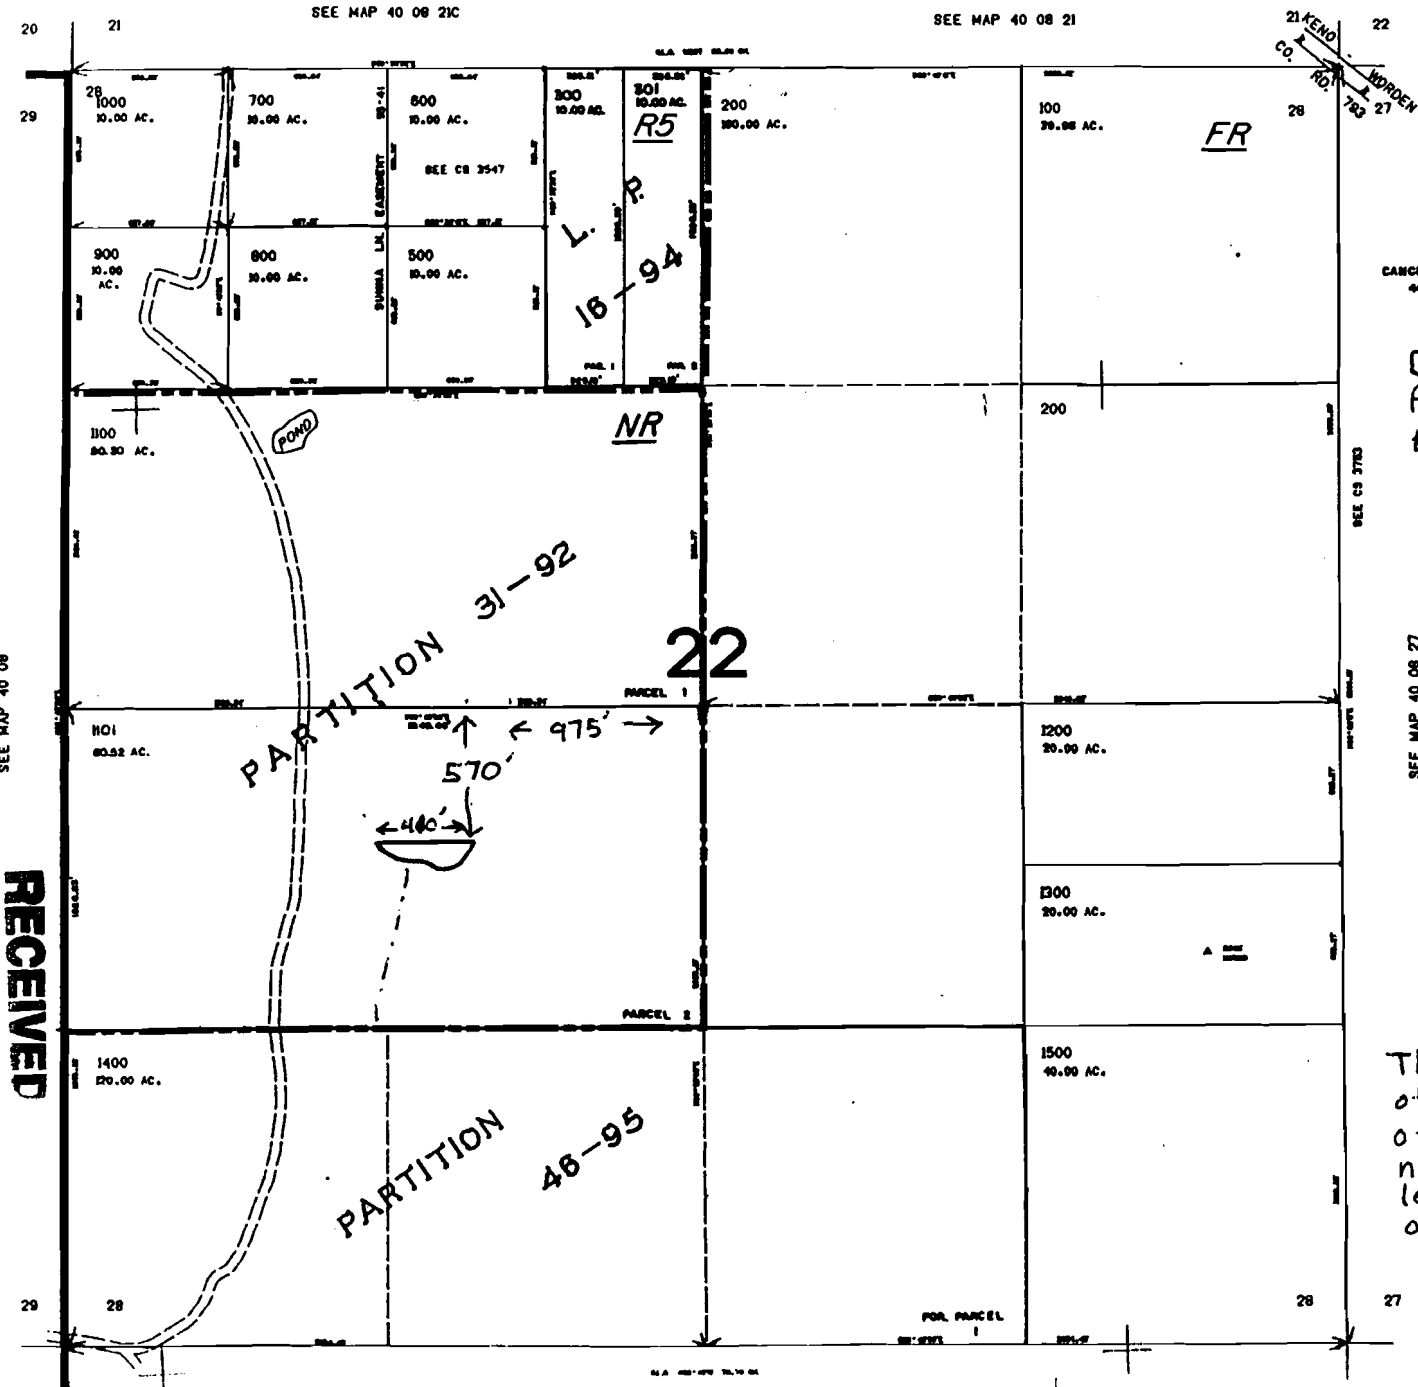

CANCELLED NO. 400

Dana Eckard + Elizabeth Dar
 P.O. Box 1143
 Klamath Falls,
 Oregon 97601
 File R81294
 Permit R12127

This map is for the purpose
 of identifying the location
 of a water right. It is
 not intended to provide
 legal dimensions or locations
 of property lines.

R-12127
 710834

141000