


T35S R12E AND T36S R12E

W.M.

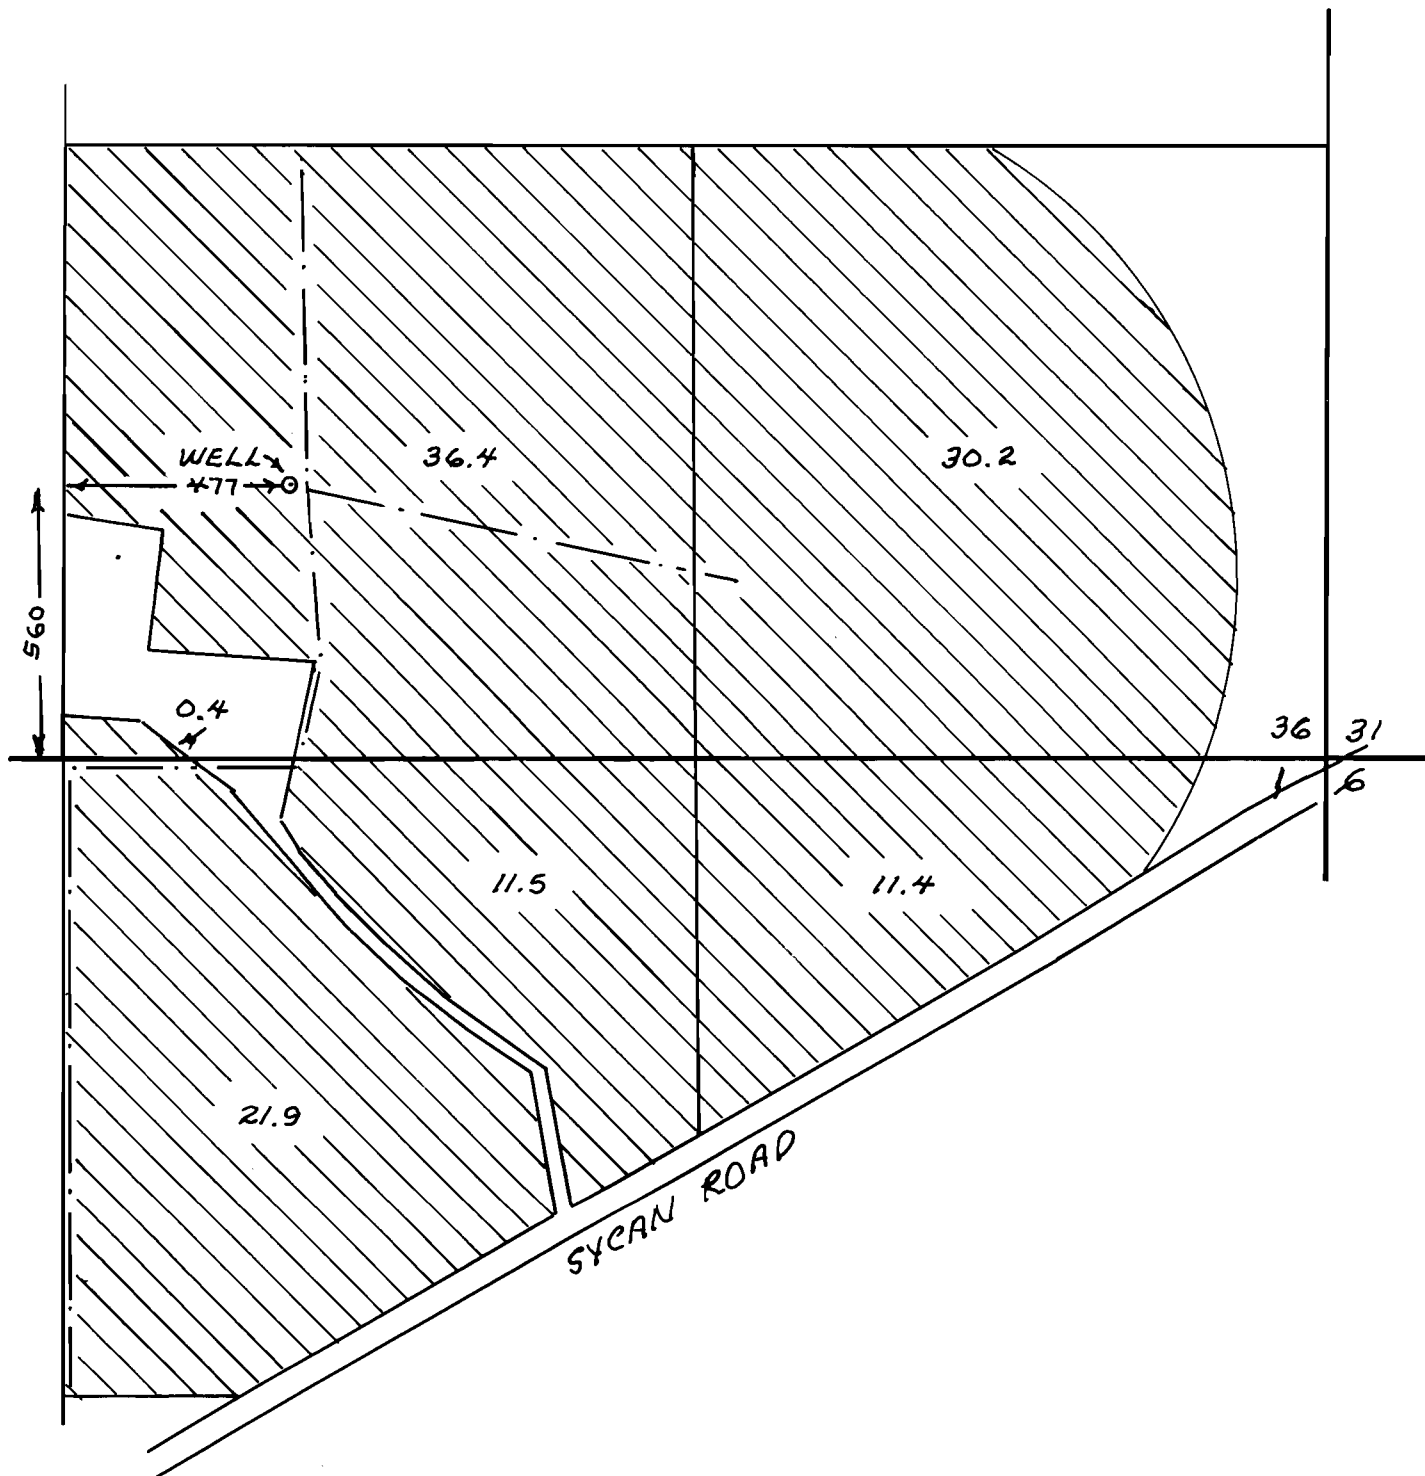

FINAL PROOF SURVEY

UNDER

APPLICATION No. G-13095

PERMIT No. G-12593

IN THE NAME OF

TED AND JUDY GLIDEWELL

SURVEYED: MAY 4, 2000 BY: DONALD A. GRESDEL
WRE 240

SCALE: 1" = 400'

Certified Water Right Survey
#240
Donald A. Gresdel
Donald A. Gresdel
May 22, 1991
EXPIRES: 6/30/01