

Form A1-187
March 1961

UNITED STATES
DEPARTMENT OF THE INTERIOR
BUREAU OF LAND MANAGEMENT


SECTION 18

Oregon State Water Filings

NE 1/4 NW 1/4

TOWNSHIP 29S, RANGE 27E, W. M.

Tied in with aerial photos and O.S.H.D. Quad Maps

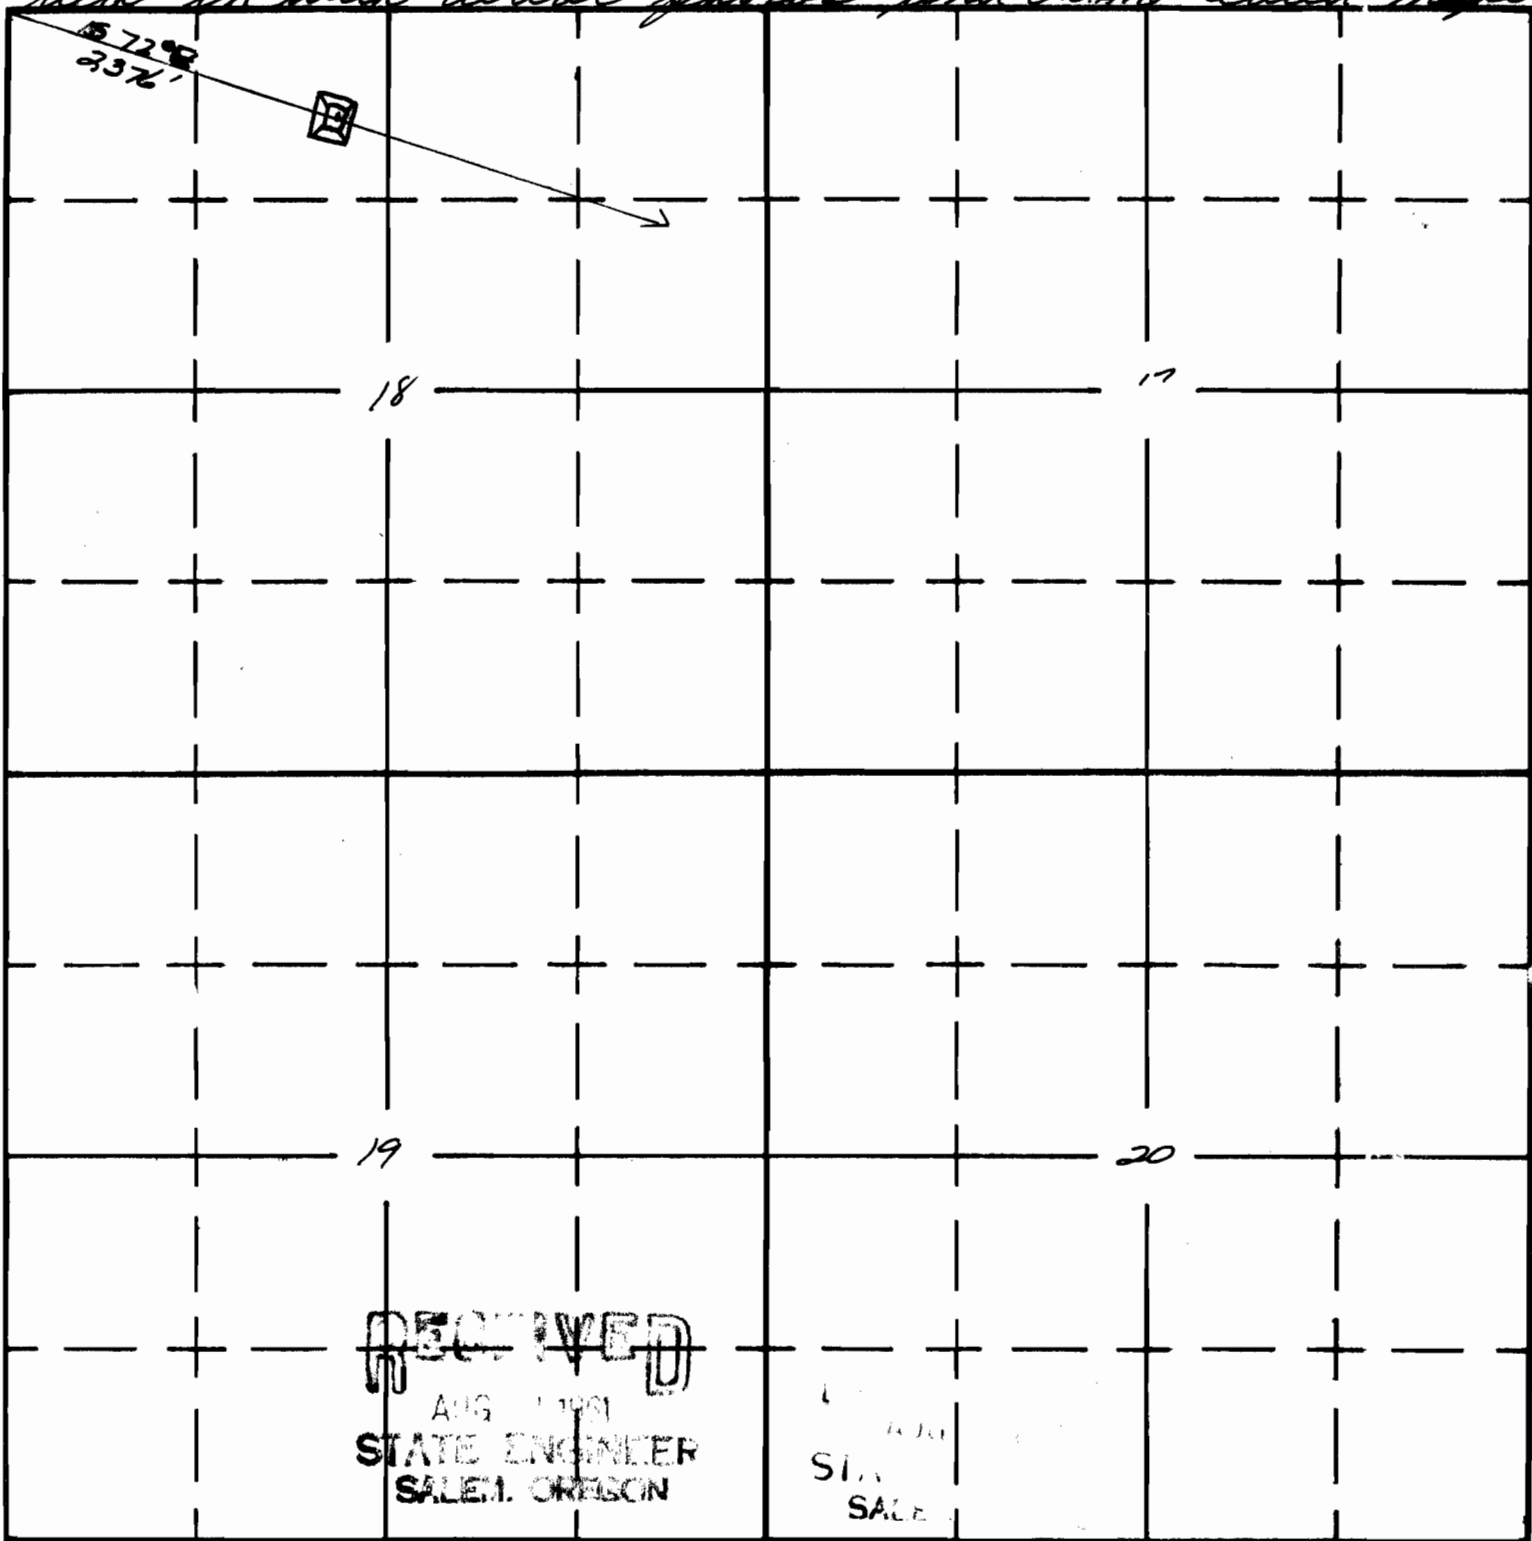

APPLICATION No. R-35971
PERMIT No. R-3744