

L.A1-187
h 1961

UNITED STATES
DEPARTMENT OF THE INTERIOR
BUREAU OF LAND MANAGEMENT

R-7143
76842

SECTION 35


Oregon State Water Filings

1E 1/4 NE 1/4

TOWNSHIP 39S, RANGE 14E, W. M.

Tied-in with aerial photos & O.S.H.D. Quad Maps.

Middle Creek Middle-

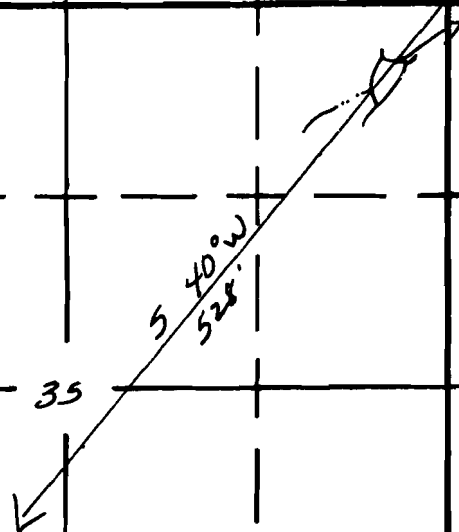

South

APPLICATION No. R-36371
DEPARTMENT R 7143