


Form AI-187
March 1961

UNITED STATES
DEPARTMENT OF THE INTERIOR
BUREAU OF LAND MANAGEMENT

SECTION 5
NW 1/4 NE 1/4

Oregon State Water Filings

TOWNSHIP 29S, RANGE 12E, W. M.

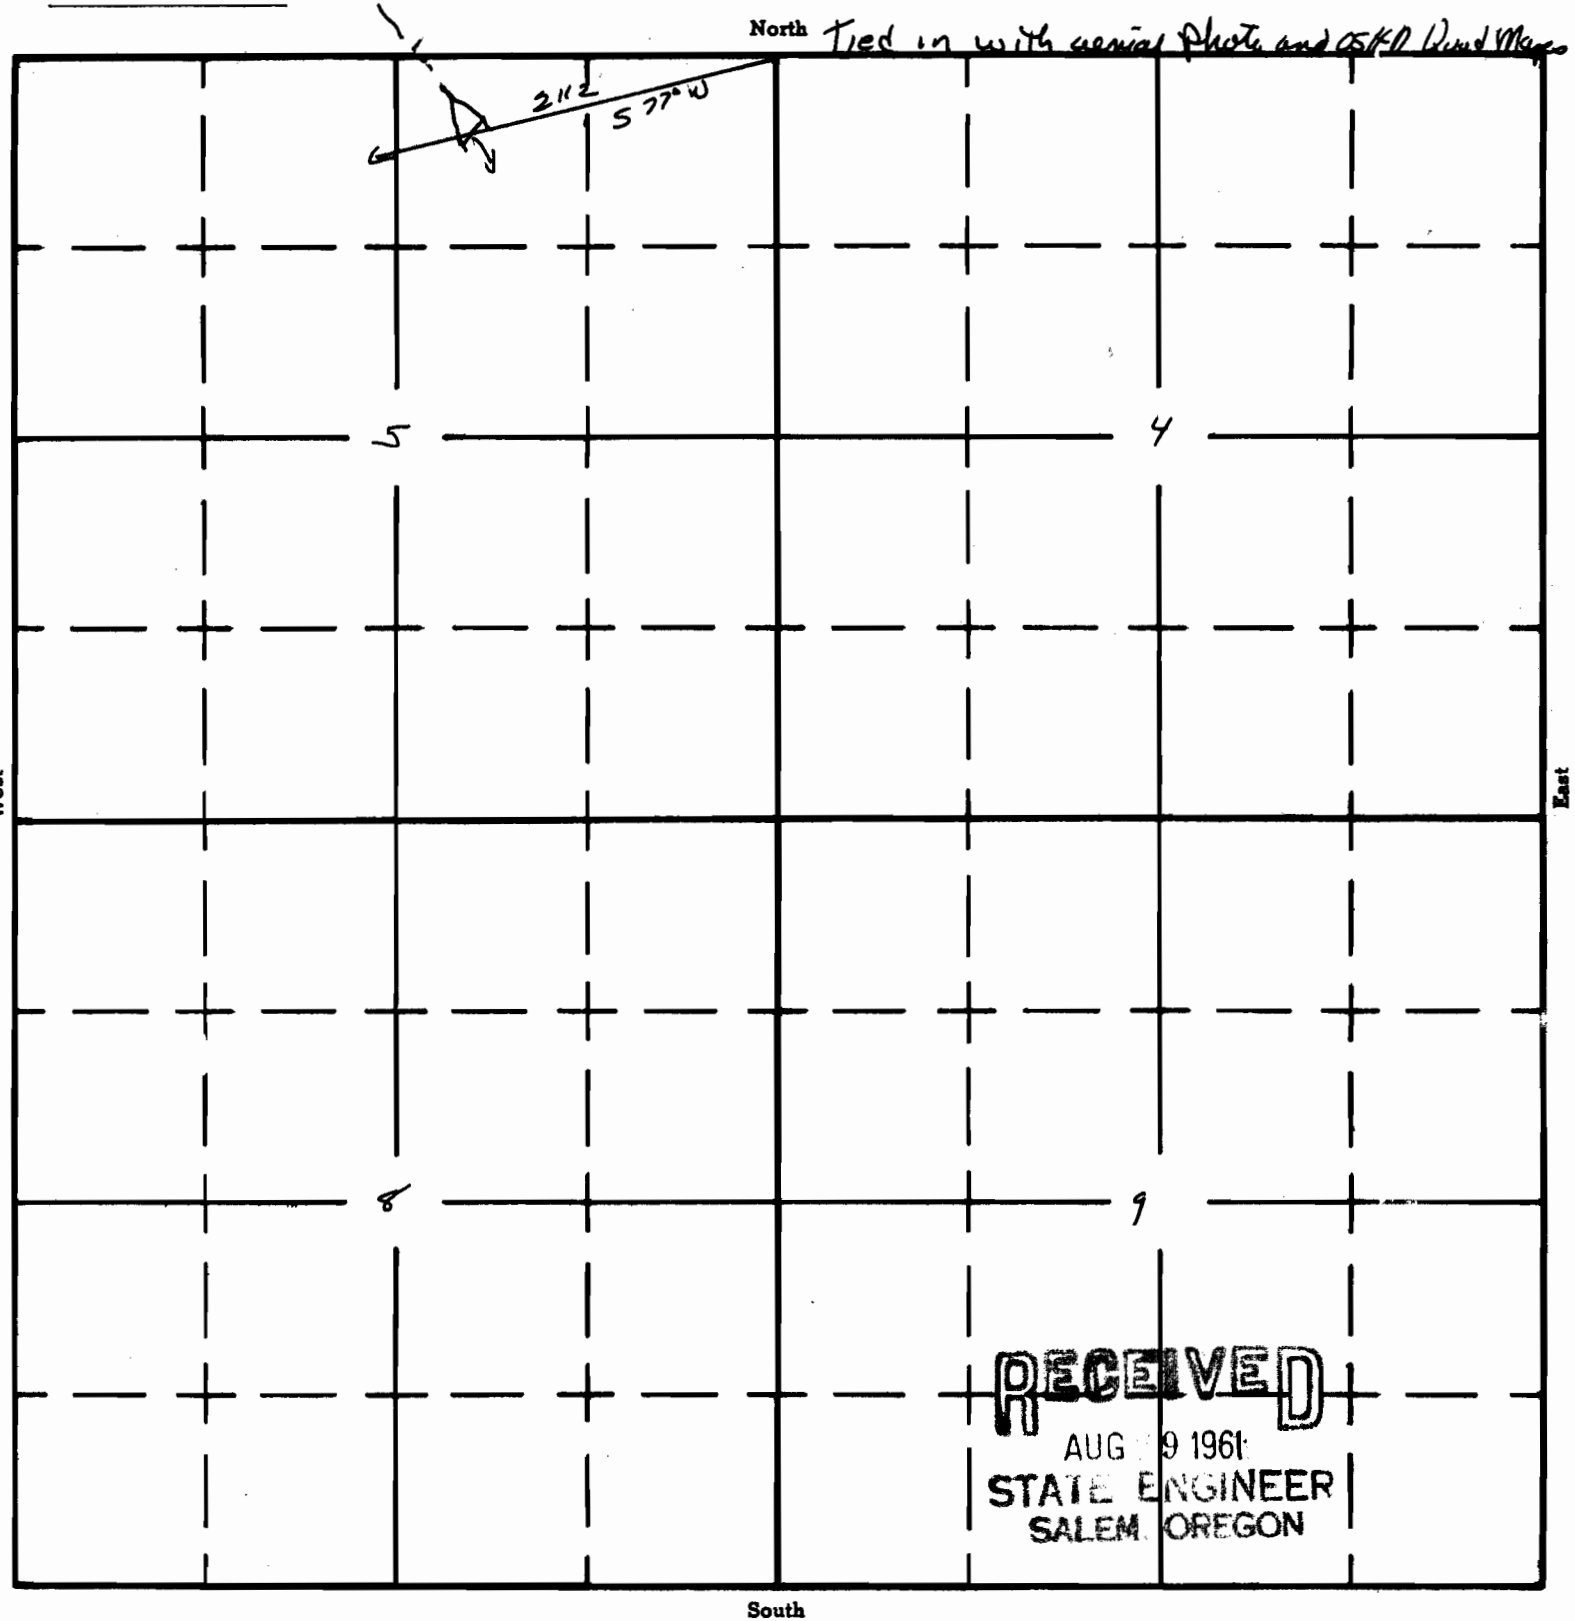

APPLICATION No. A-36954
PERMIT No. R 7363