

R-7370

Form AI-187
March 1961

UNITED STATES
DEPARTMENT OF THE INTERIOR
BUREAU OF LAND MANAGEMENT


RECEIVED
JAN 17 1963
76844

SECTION
14

Oregon State Water Filings

TOWNSHIP 28S, RANGE 13E, W. M.

North

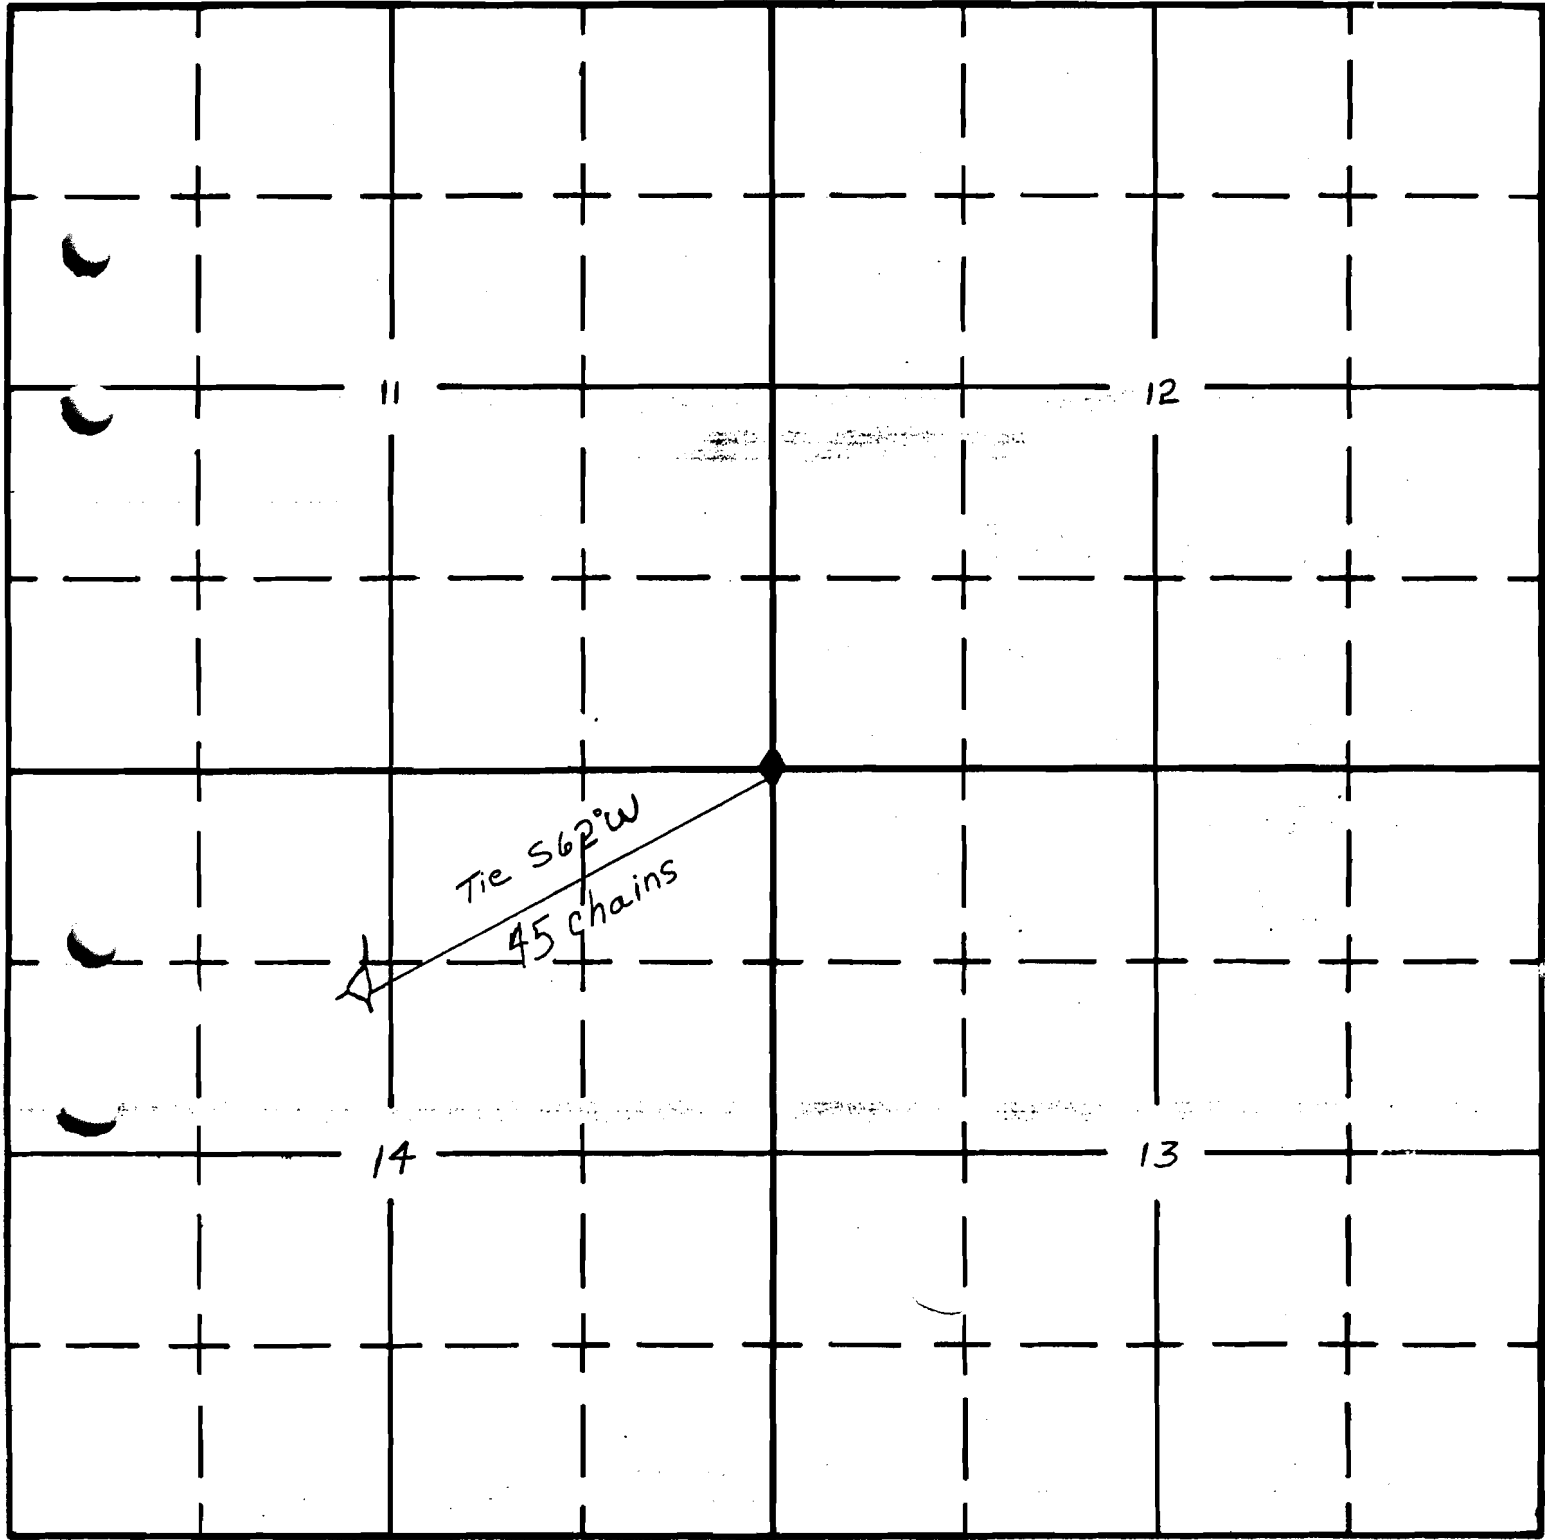

◆ - Found Survey Corner
A - Project

APPLICATION No. R-38356
PERMIT No. R-7370