RECEIVED
SEP 11 1981
WATER RESOURCES DEPT
SALEM, OREGON

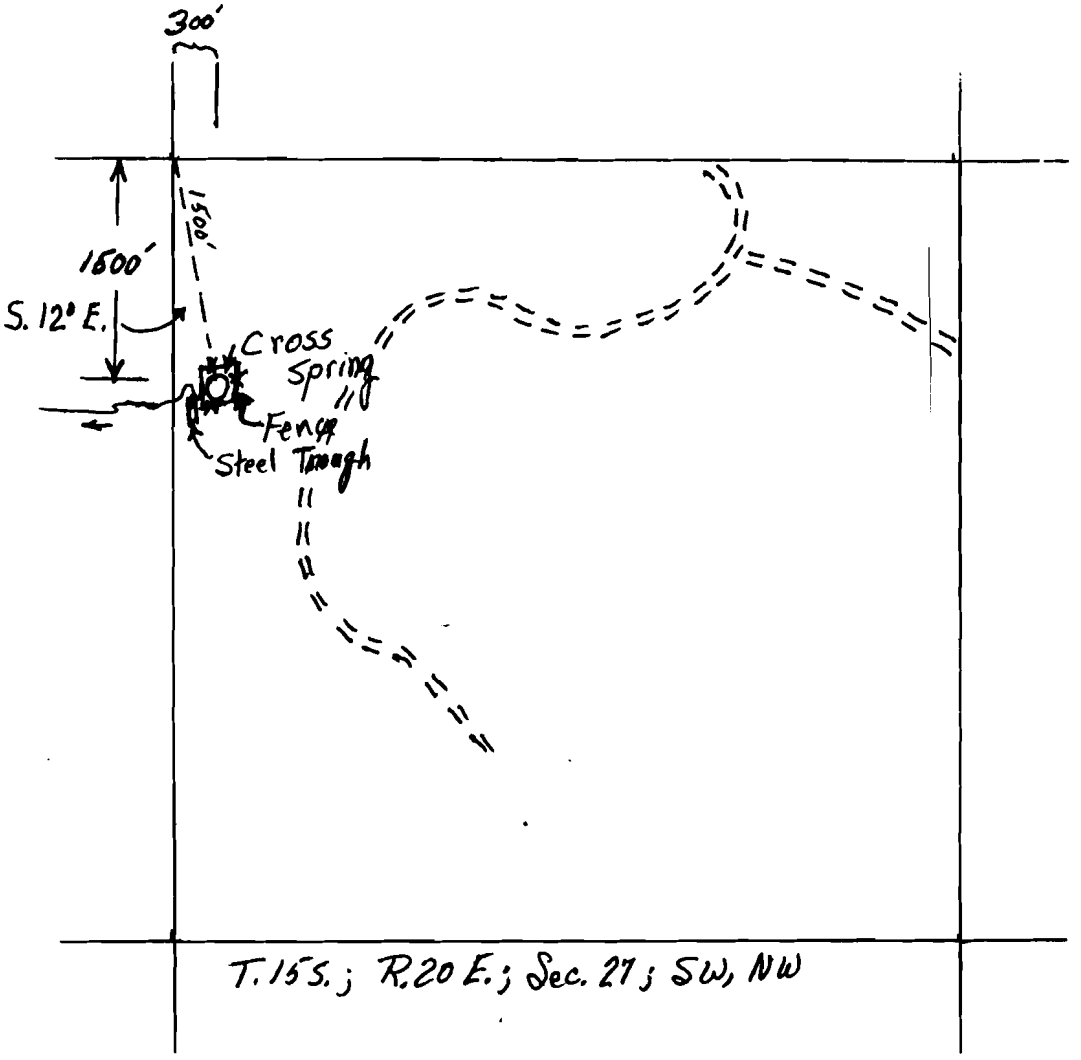

SCALE: 4 Inches = 1 Mile

NORTH

Application No. G2685
Permit No. 48850

Cert. # 76847

C. 76847

48850