


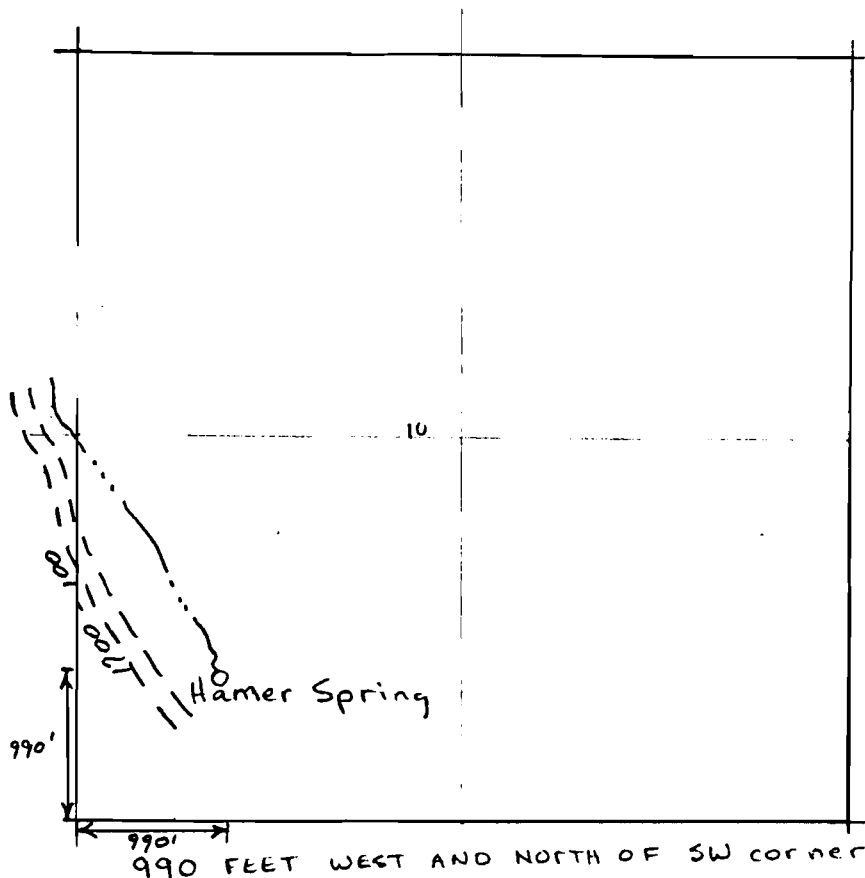

Hamer Spring

T. 18 S. R. 18 E. Sec 10



4" = 1 MILE

T. Bodortha
Aug 1981

T 17 S R 19 E
Sec 27

RECEIVED

SEP 11 1981


WATER RESOURCES DEPT
SALEM, OREGON

Application No. 62723

Permit No. 48656

Cont. # 76848

Spring development

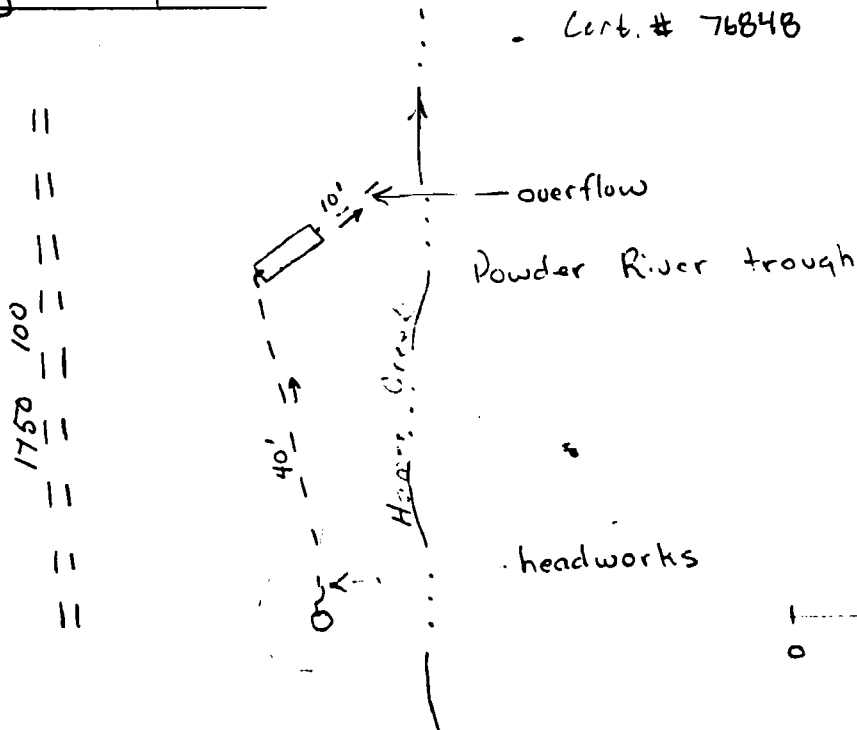

0 10 20 FEET 40

C-76848

48656