


48581 76849

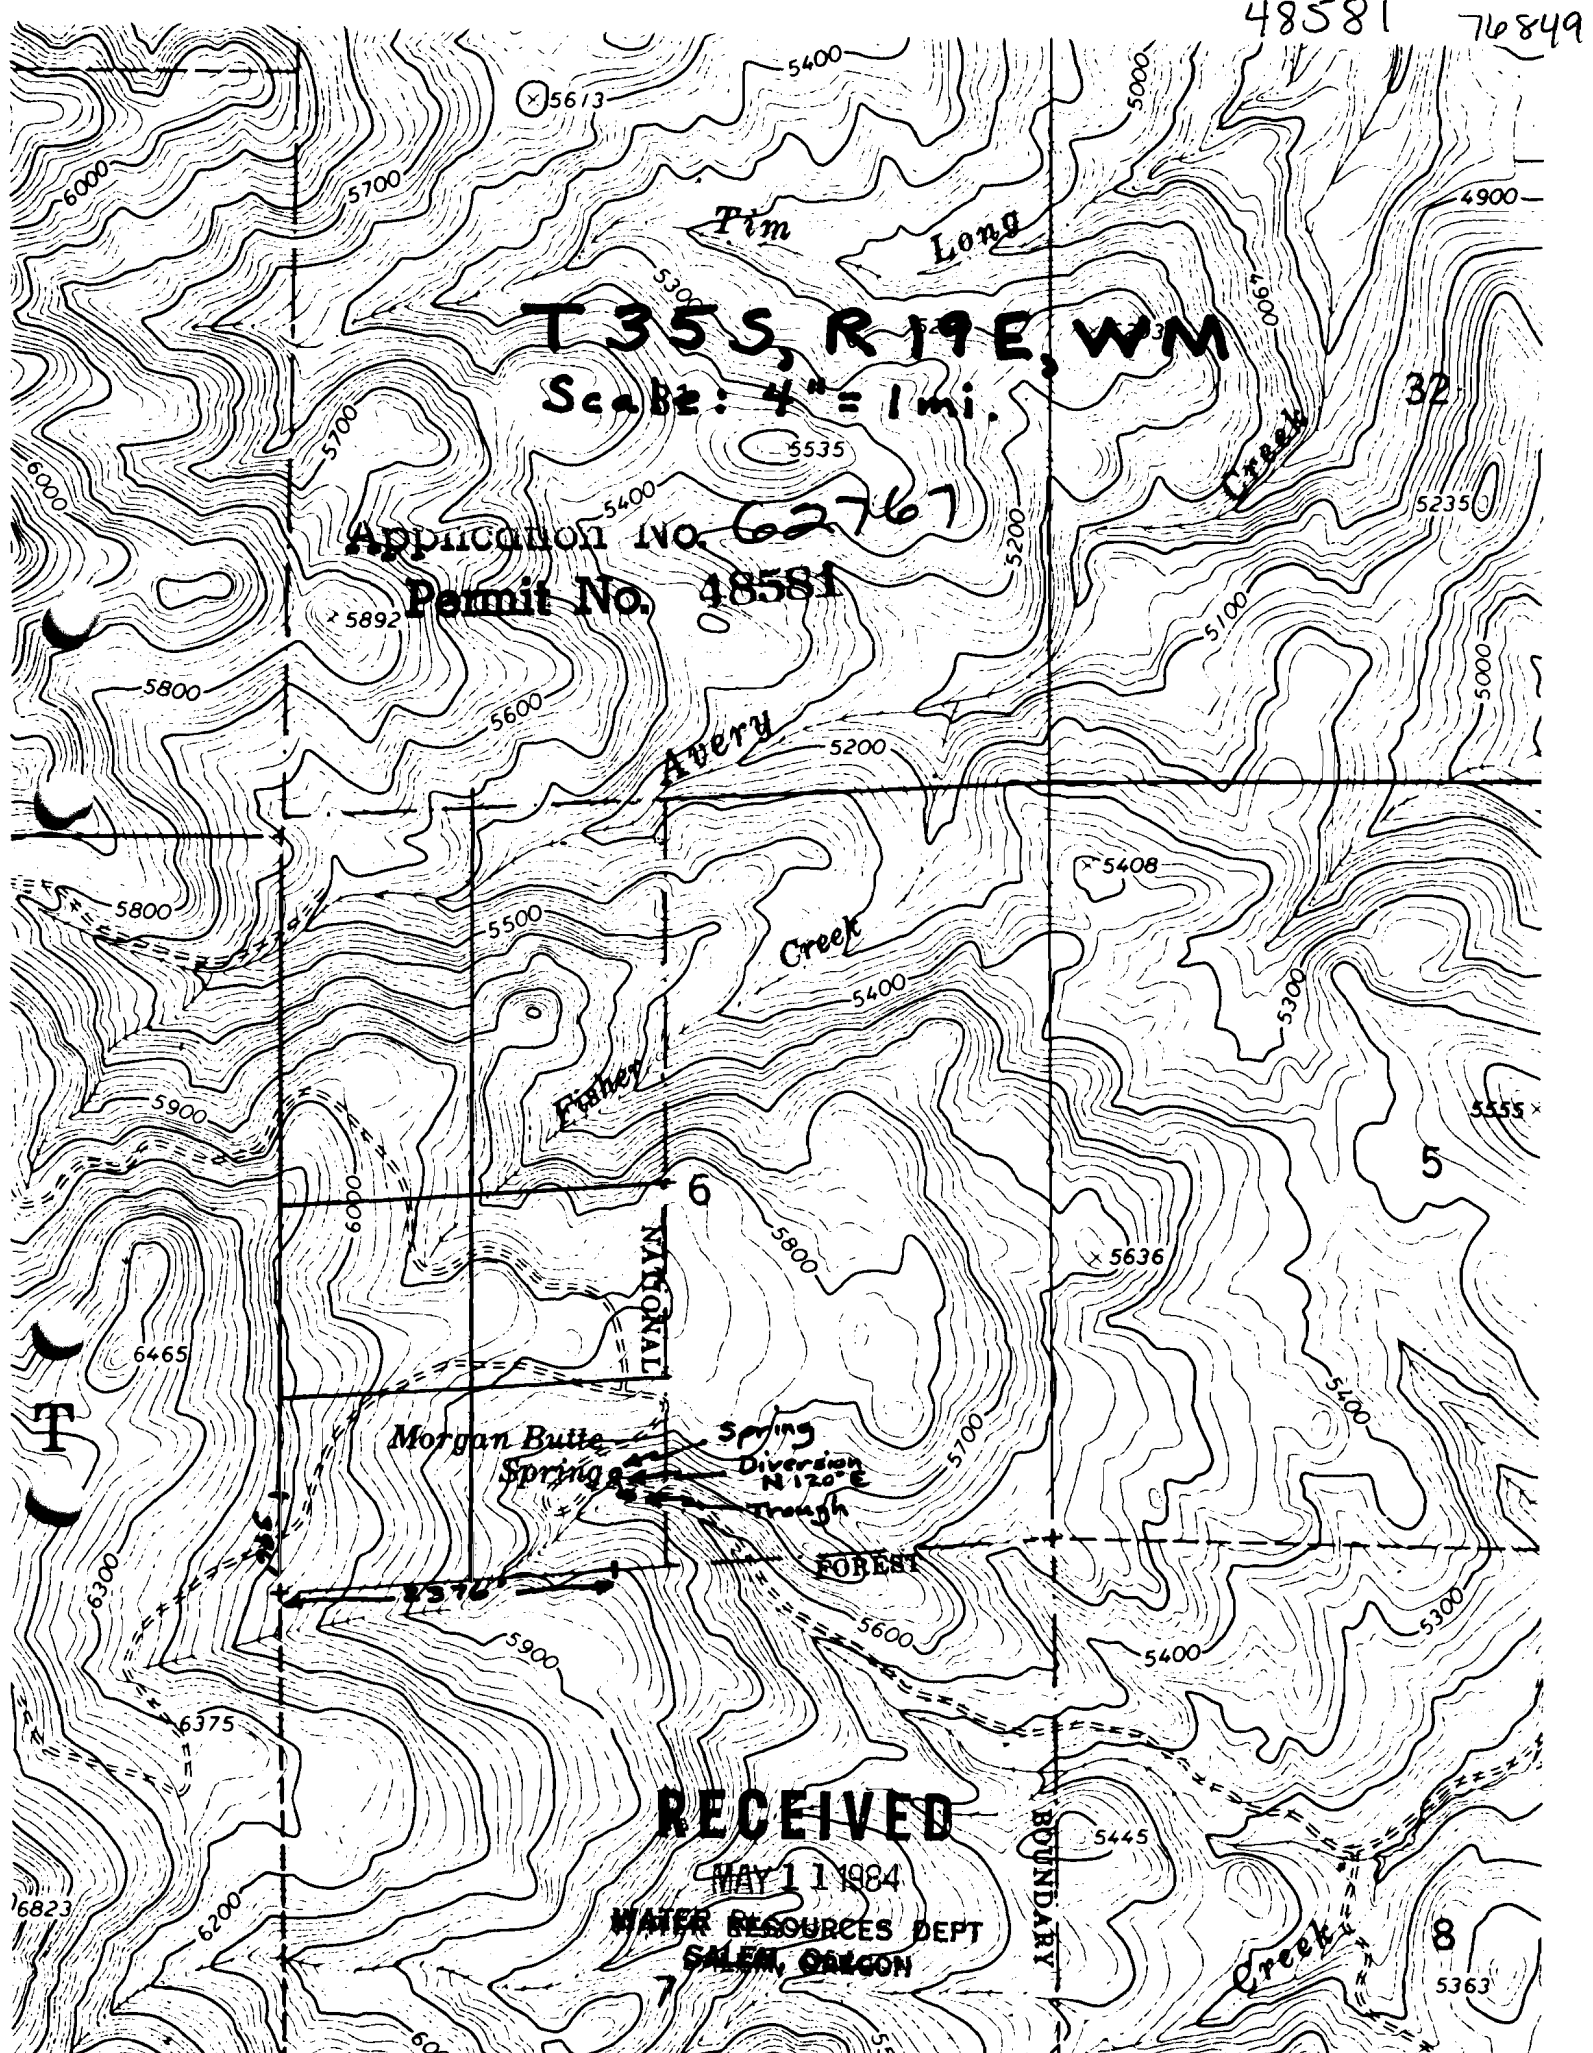

T35S, R19E, WM
Scale: 4" = 1 mi.

Application No. 62767
Permit No. 48581

RECEIVED

MAY 11 1984

WATER RESOURCES DEPT
SALEM, OREGON