


48637 76852

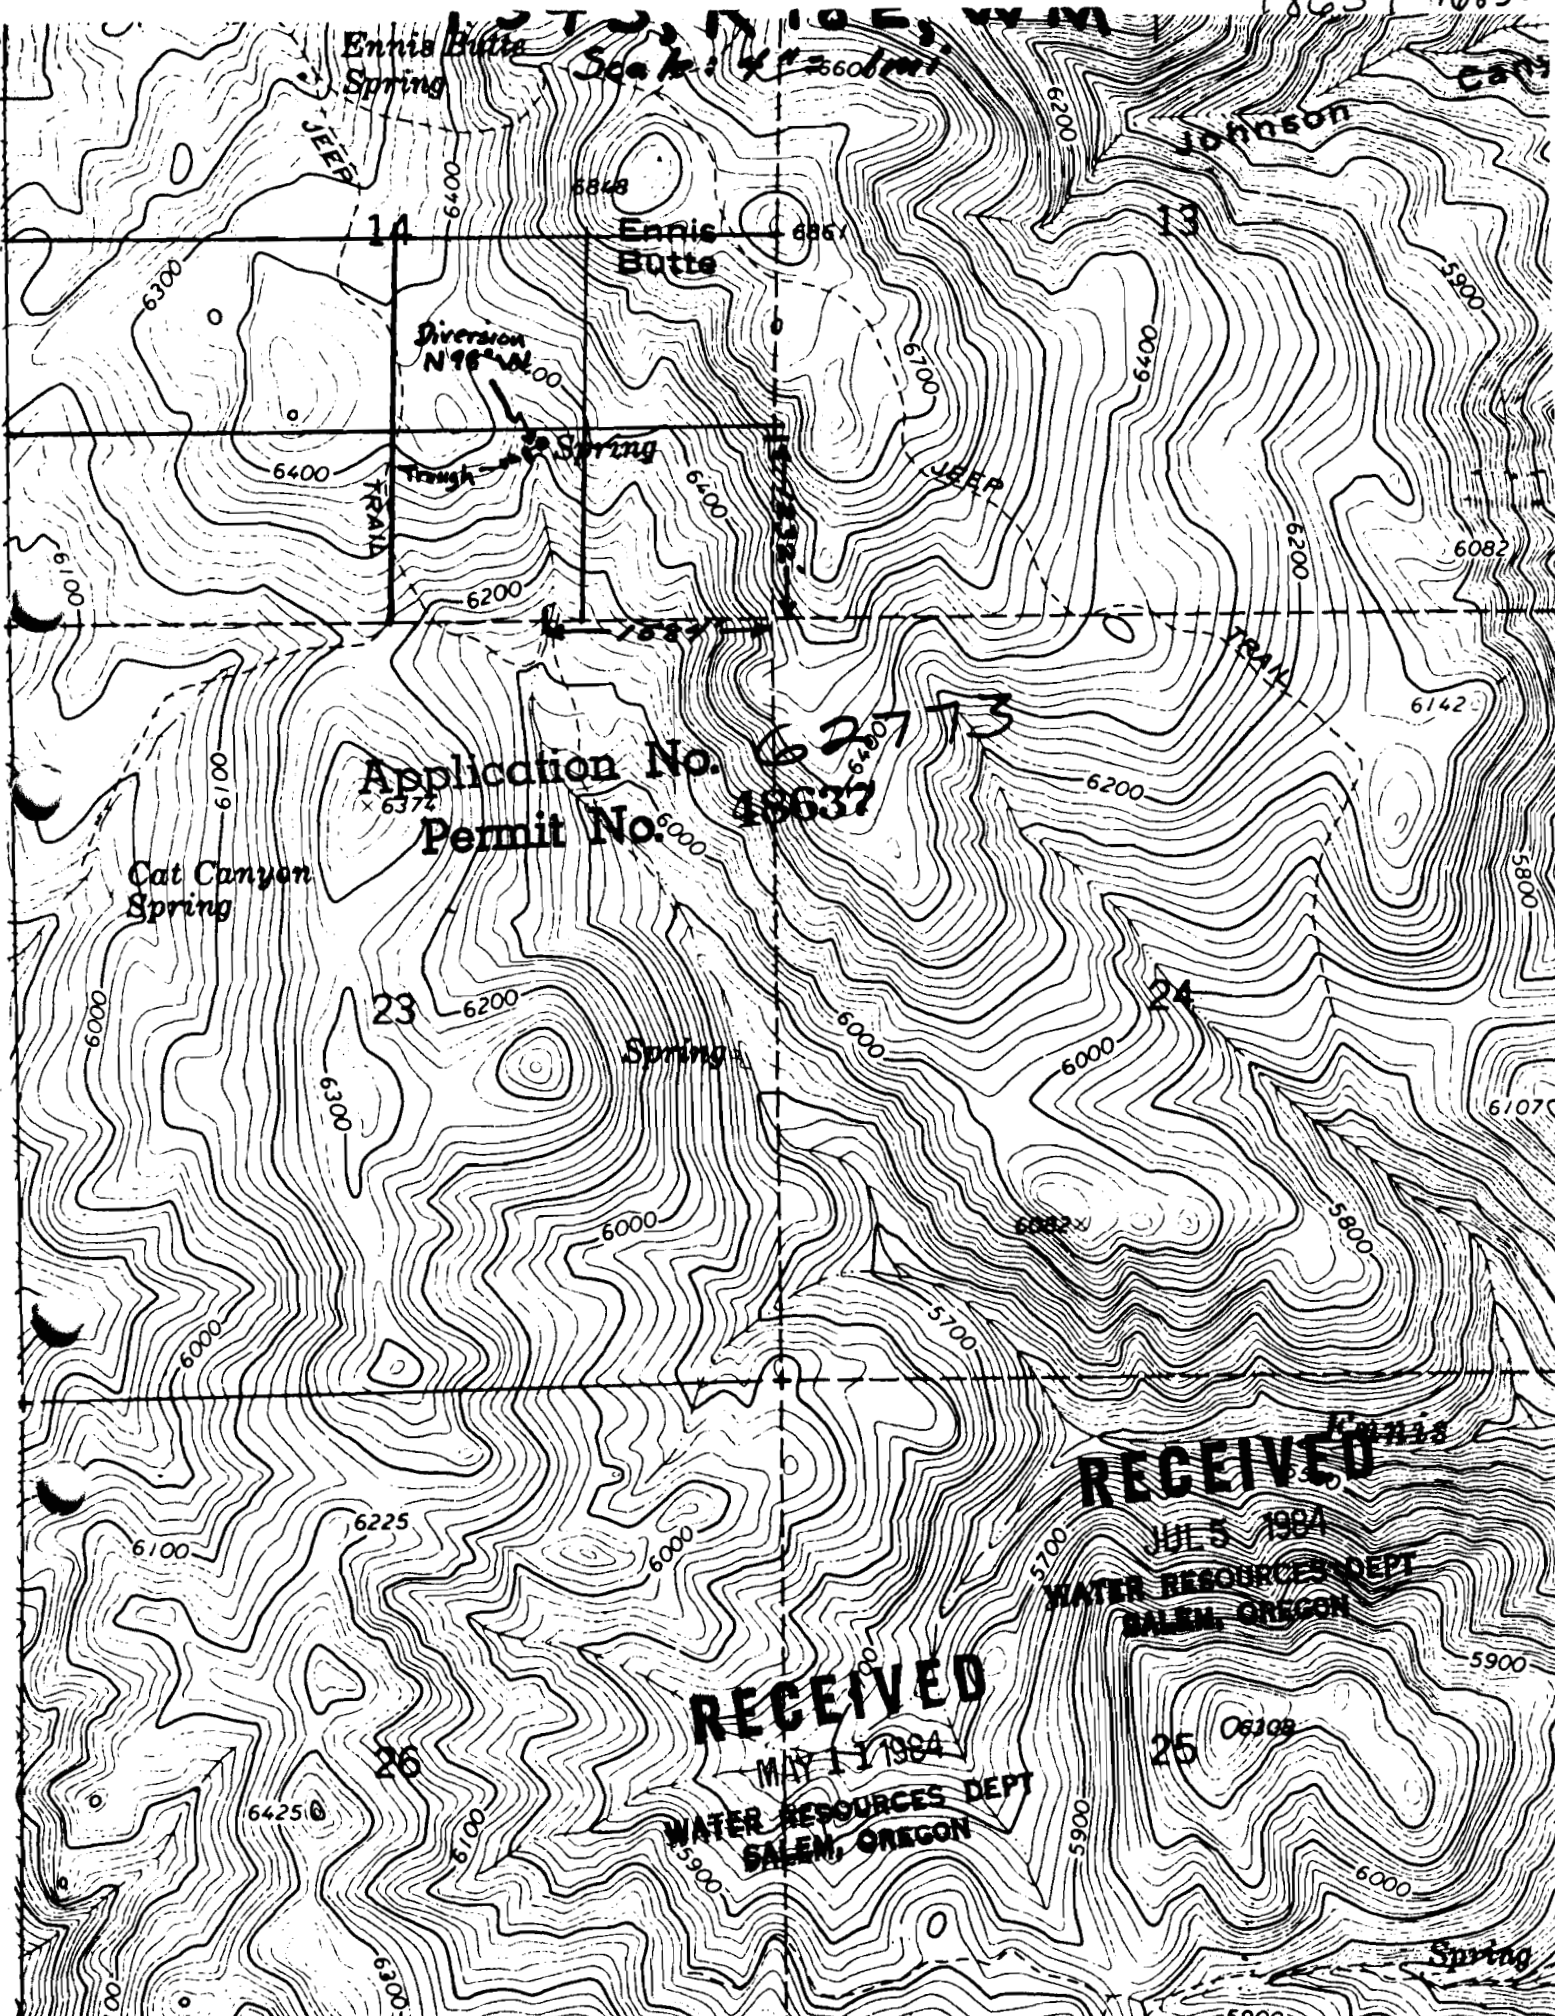

Application No. 62773
Permit No. 48637

RECEIVED

JUL 5 1984

WATER RESOURCES DEPT
SALEM, OREGON

RECEIVED

MAY 11 1984

WATER RESOURCES DEPT
SALEM, OREGON