


RECEIVED

SEP 8 1963

**WATER RESOURCES DEPT.
SALEM, OREGON**

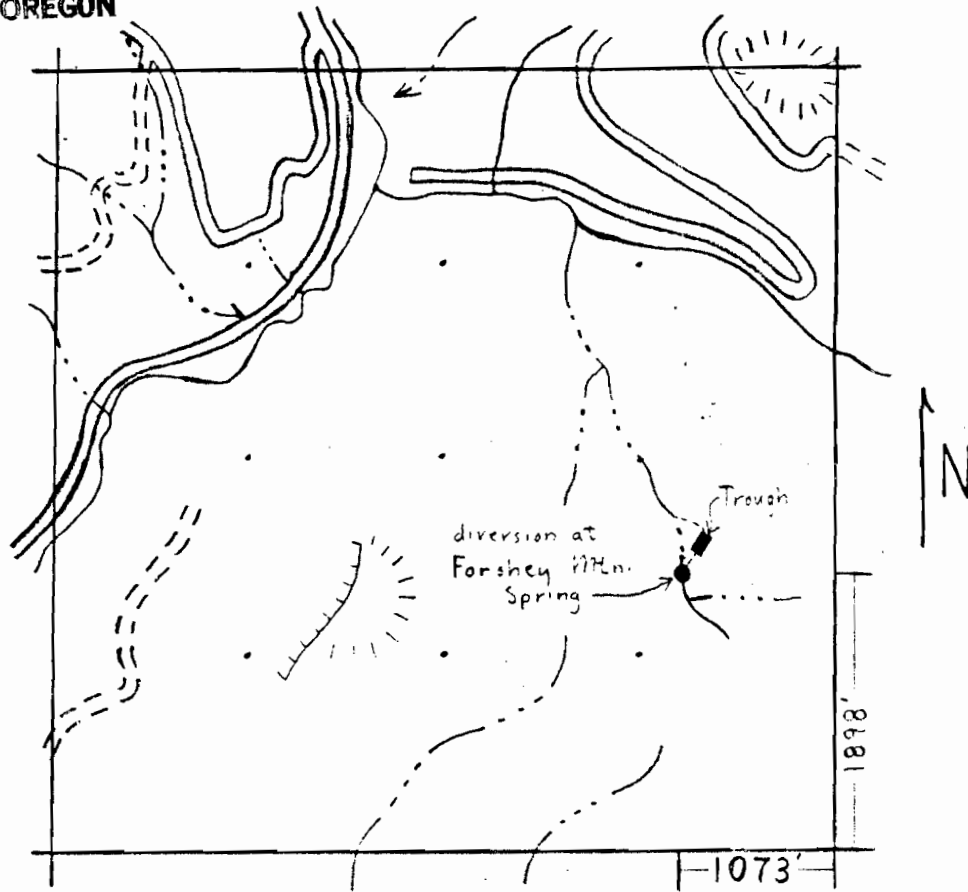

4 inches = 1 mile

T 7 S R 43 E Sec 35

Application No. 62817

Permit No. 48899