


RECEIVED

SEP 26 1983

WATER RESOURCES DEPT.
SALEM, OREGON

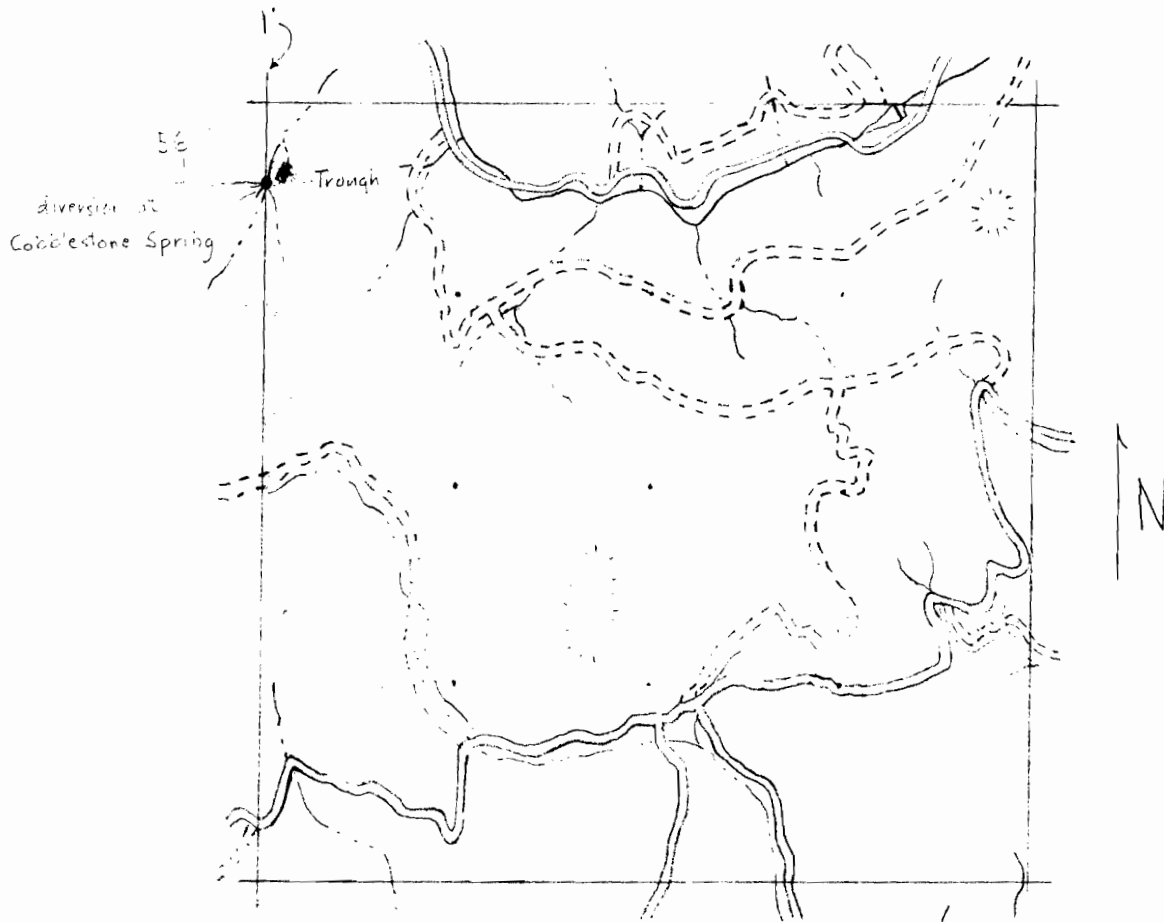

4 inches = 1 mile

T7S R43E Sec 22

Application No. 66747
Permit No. 50617

USFS # 7-7367