

RECEIVED



SEP 17 1999

WATER RESOURCES DEPT.
SALEM, OREGON

FINAL PROOF SURVEY MAP
IN THE NAME OF B. OTTO FREIENMUTH

SECTION 19, TOWNSHIP 23, SOUTH, RANGE 9 WEST, W.M.

APPLICATION S-73939 PERMIT 52251

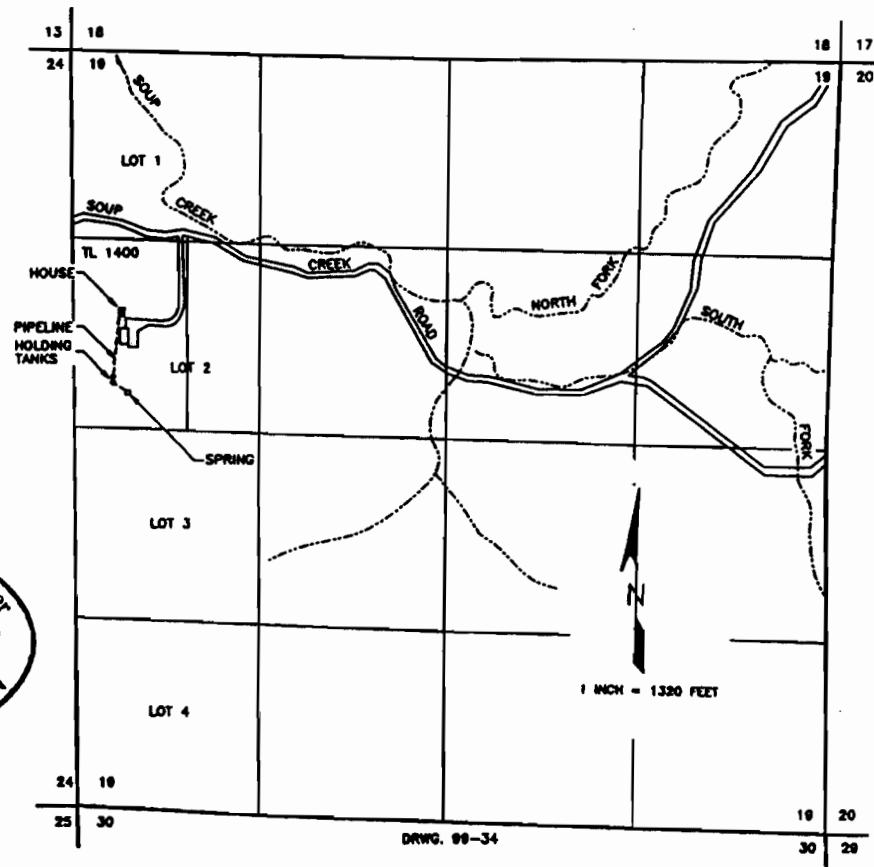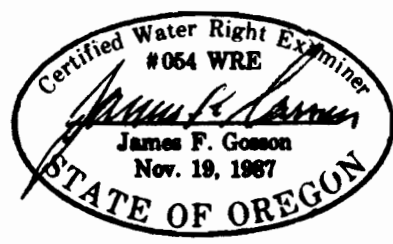

THE SPRING IS LOCATED 2930 FEET SOUTH AND 410 FEET EAST FROM THE NORTHWEST CORNER OF SECTION 19, BEING WITHIN THE SW 1/4 NW 1/4 SECTION 19, TOWNSHIP 23 SOUTH, RANGE 9 WEST, W.M., DOUGLAS COUNTY.

THE PURPOSE OF THIS MAP IS TO IDENTIFY THE LOCATION OF THE WATER RIGHT. IT IS NOT INTENDED TO PROVIDE INFORMATION RELATIVE TO THE LOCATION OF PROPERTY OWNERSHIP BOUNDARY LINES.