
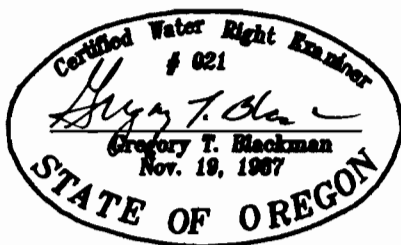


RECEIVED

APR 20 1999

WATER RESOURCES DEPT.
SALEM, OREGON

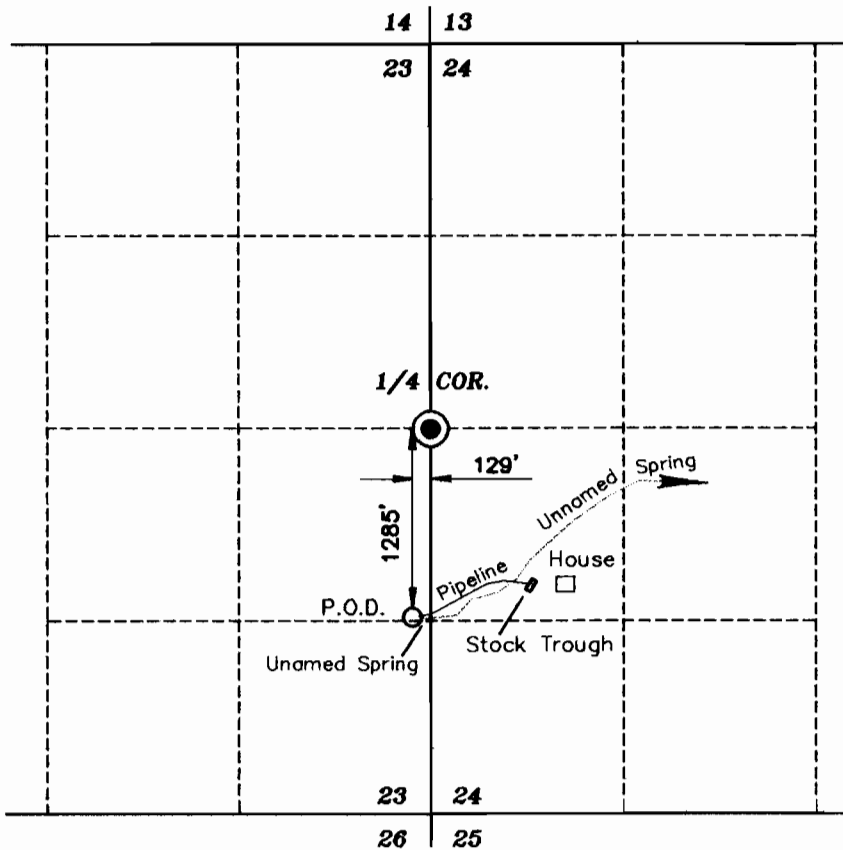

NOTE: The preparation of this map was for the purpose of identifying the location of the proposed water right and has no intent to provide dimensions or location of property ownership lines. Location information shown hereon was furnished by the applicant.

**FINAL PROOF MAP OF
WATER RIGHT FOR
WALKER FAMILY TRUST**

BY
BAGETT - GRIFFITH & BLACKMAN
2006 ADAMS AVENUE
LAGRANDE, OREGON 97850

January 11, 1999

APPLICATION NO. 73287

PERMIT NUMBER 52242