


T. 1 N. R. 13 E. W. M.

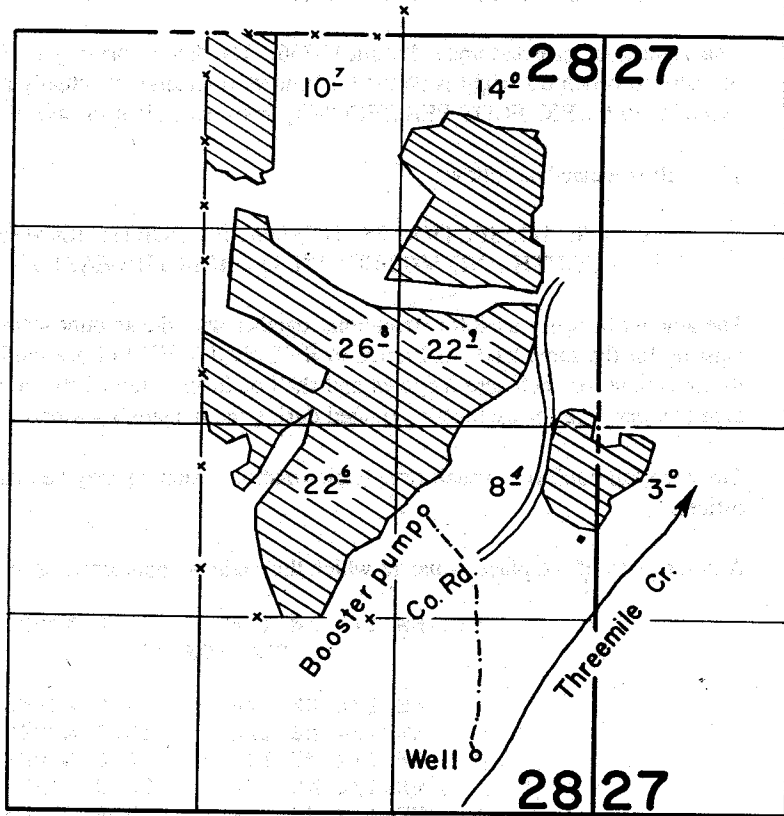

FINAL PROOF SURVEY
UNDER

Application No. U-869... Permit No. U-756...
IN NAME OF

JOHN W. & ANGIE B. STARK

Surveyed May 6, 1965, by *L. W. Sebouck*