


T.15&16S.R.7W.W.M.

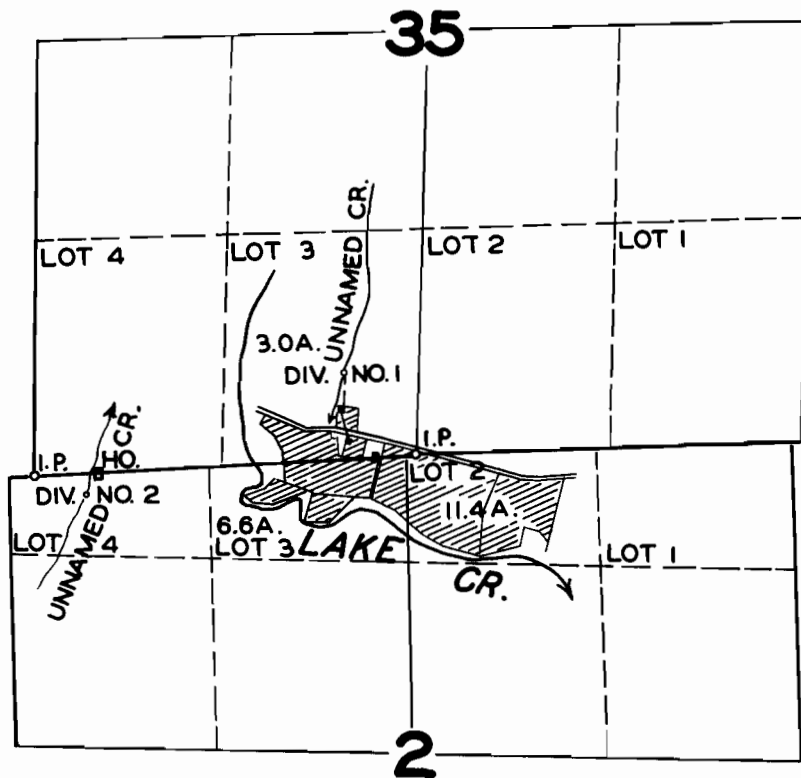

FINAL PROOF SURVEY
UNDER

Application No. **22737** Permit No. **17892**
IN NAME OF

ALBERT MOE & ODELIA J. MOE

Surveyed **JUL. 29, 1948**, by **JAS. E. BUNNELL**