



Form AI-187
March 1961

UNITED STATES
DEPARTMENT OF THE INTERIOR
BUREAU OF LAND MANAGEMENT

SECTION
NW⁴ SE⁴
SEC 3

Oregon State Water Filings

TOWNSHIP 23S, RANGE 43E, W. M.

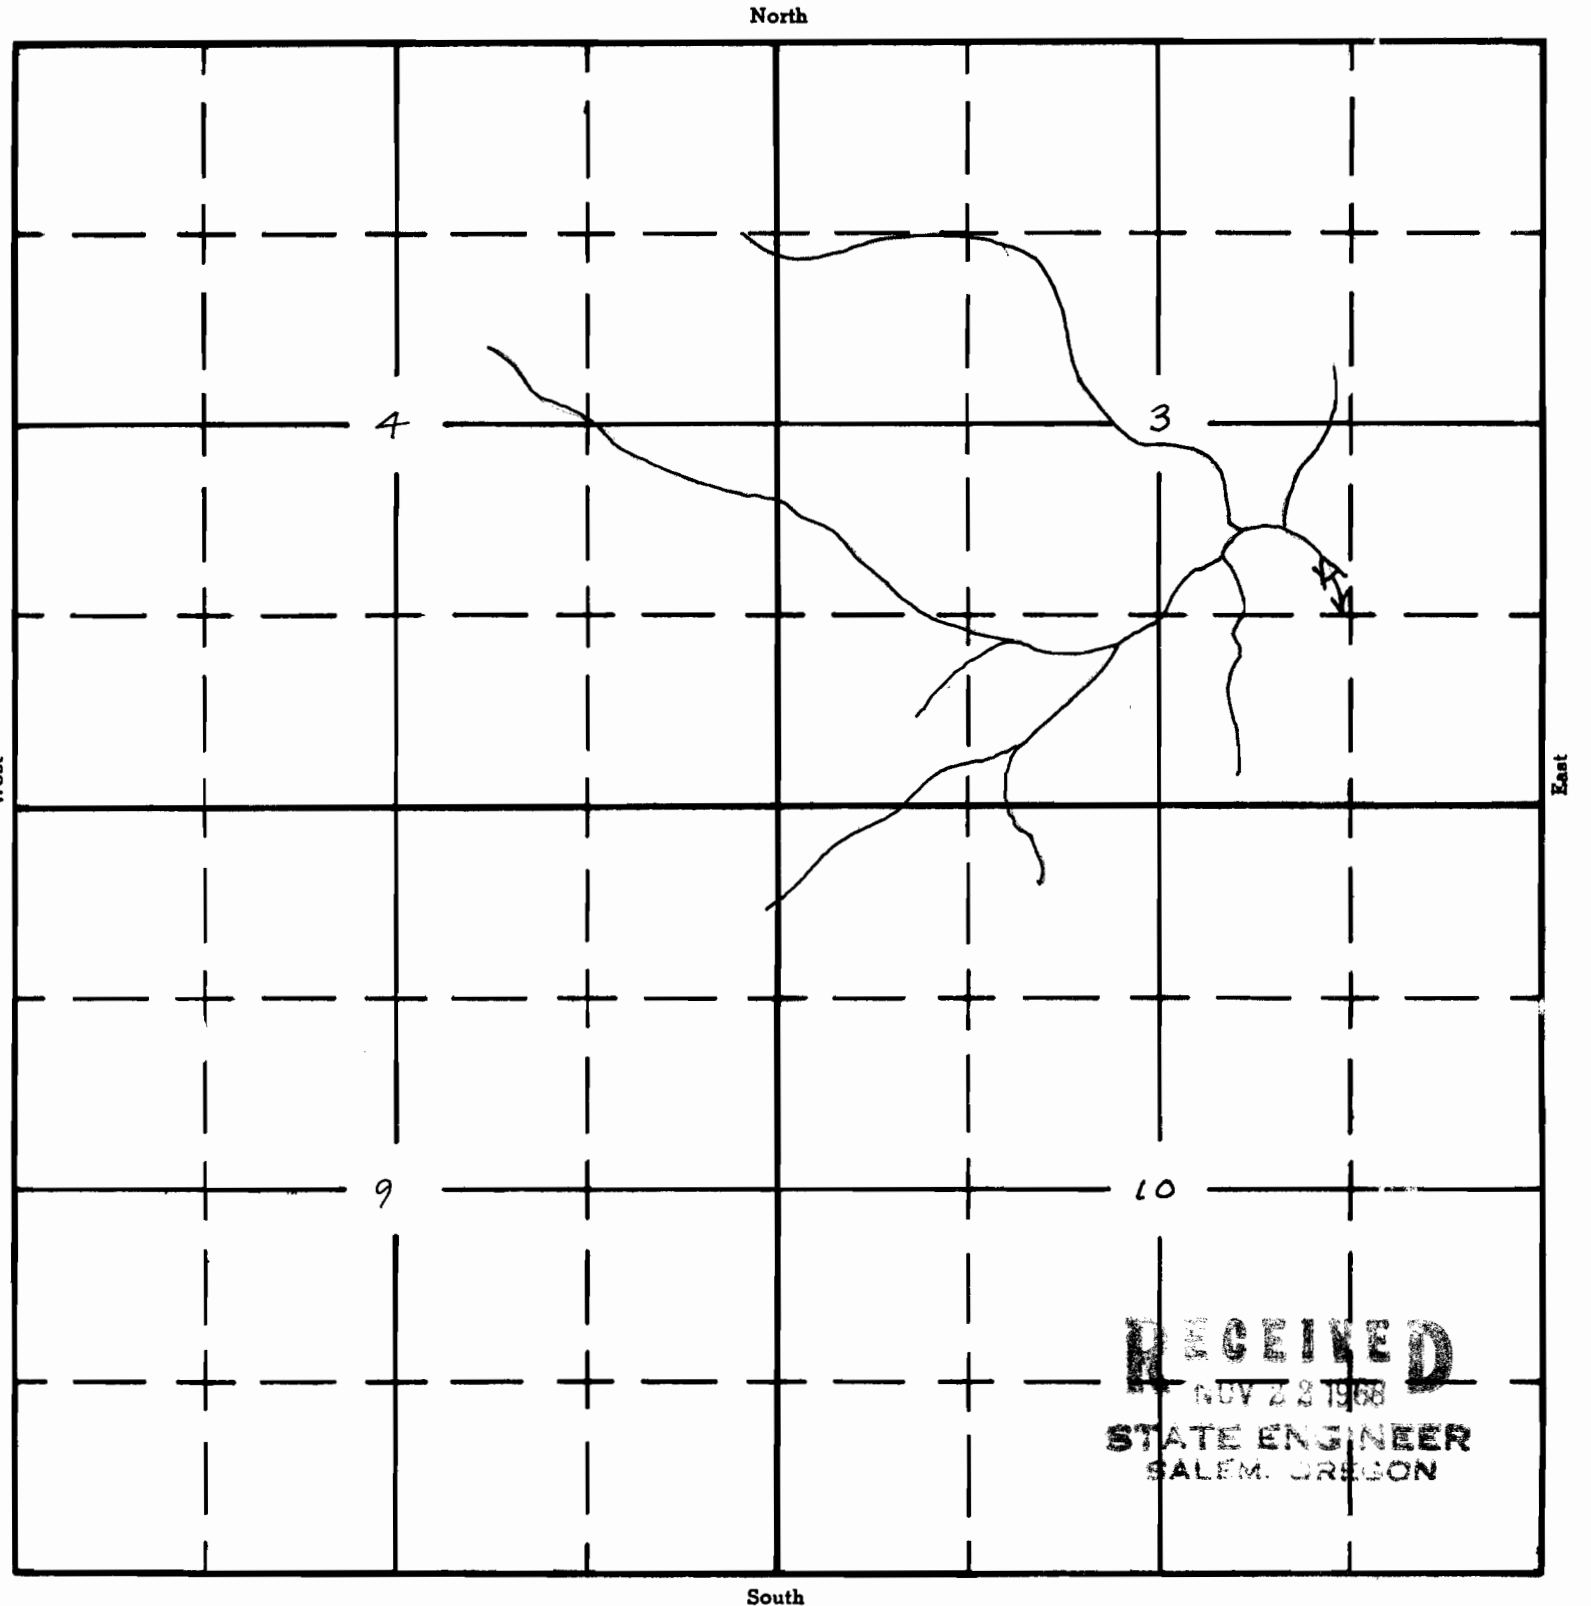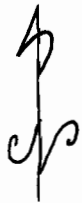

LONG DRAW RES.

APPLICATION No. R-45573
PERMIT No. 7452