


42884
76866

T.34S., R.7E., W.M.

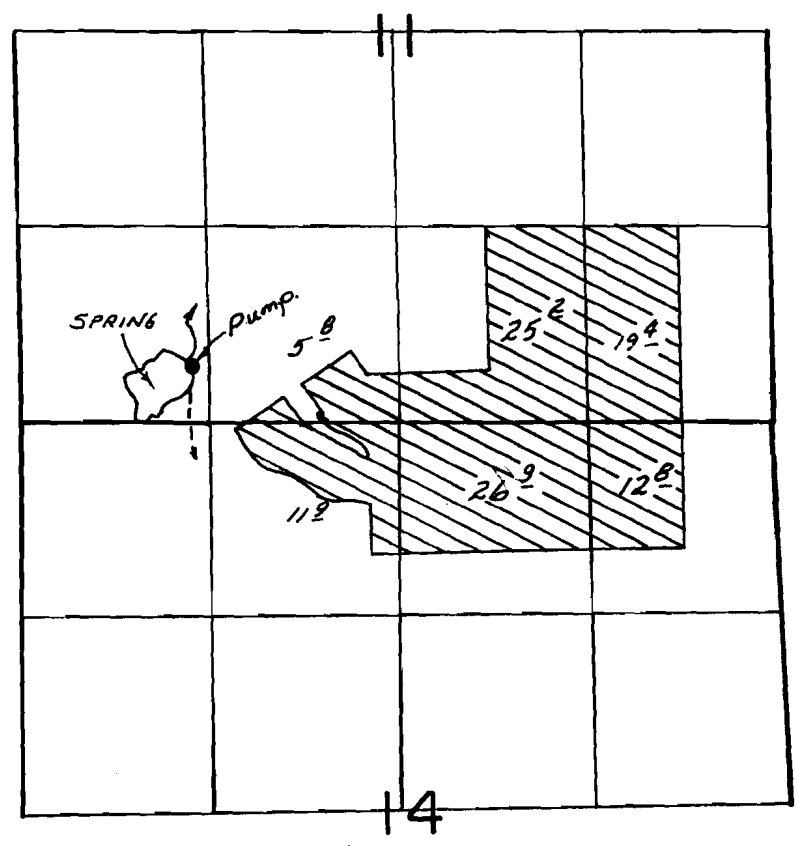

Div. Pt. Loc.: 350' N. & 1200' E. FROM SW COR. SEC. 11

FINAL PROOF SURVEY UNDER

Application No. 56271. Permit No. 42884....
IN NAME OF

.....JOHN M. SCHOONOVER.....

Surveyed JULY.17. 19.91., by ..B.W.BISHOP..

Williamson Bl. E. K. Marsh