

10375 Hiway 66

T39S R3E S33 #5800

Application No. R81144

RECEIVED
MAY 10 1996
WATER RESOURCES DEPT.
SALEM, OREGON

Well, road, & fence exist.
All other cons. is proposed.

Permit No. R11984


T.L.5800

P
r
o
p
o
s
e
d
l
i
n
e

RECEIVED

AUG 21 2000

WATER RESOURCES DE
SALEM, OREGON

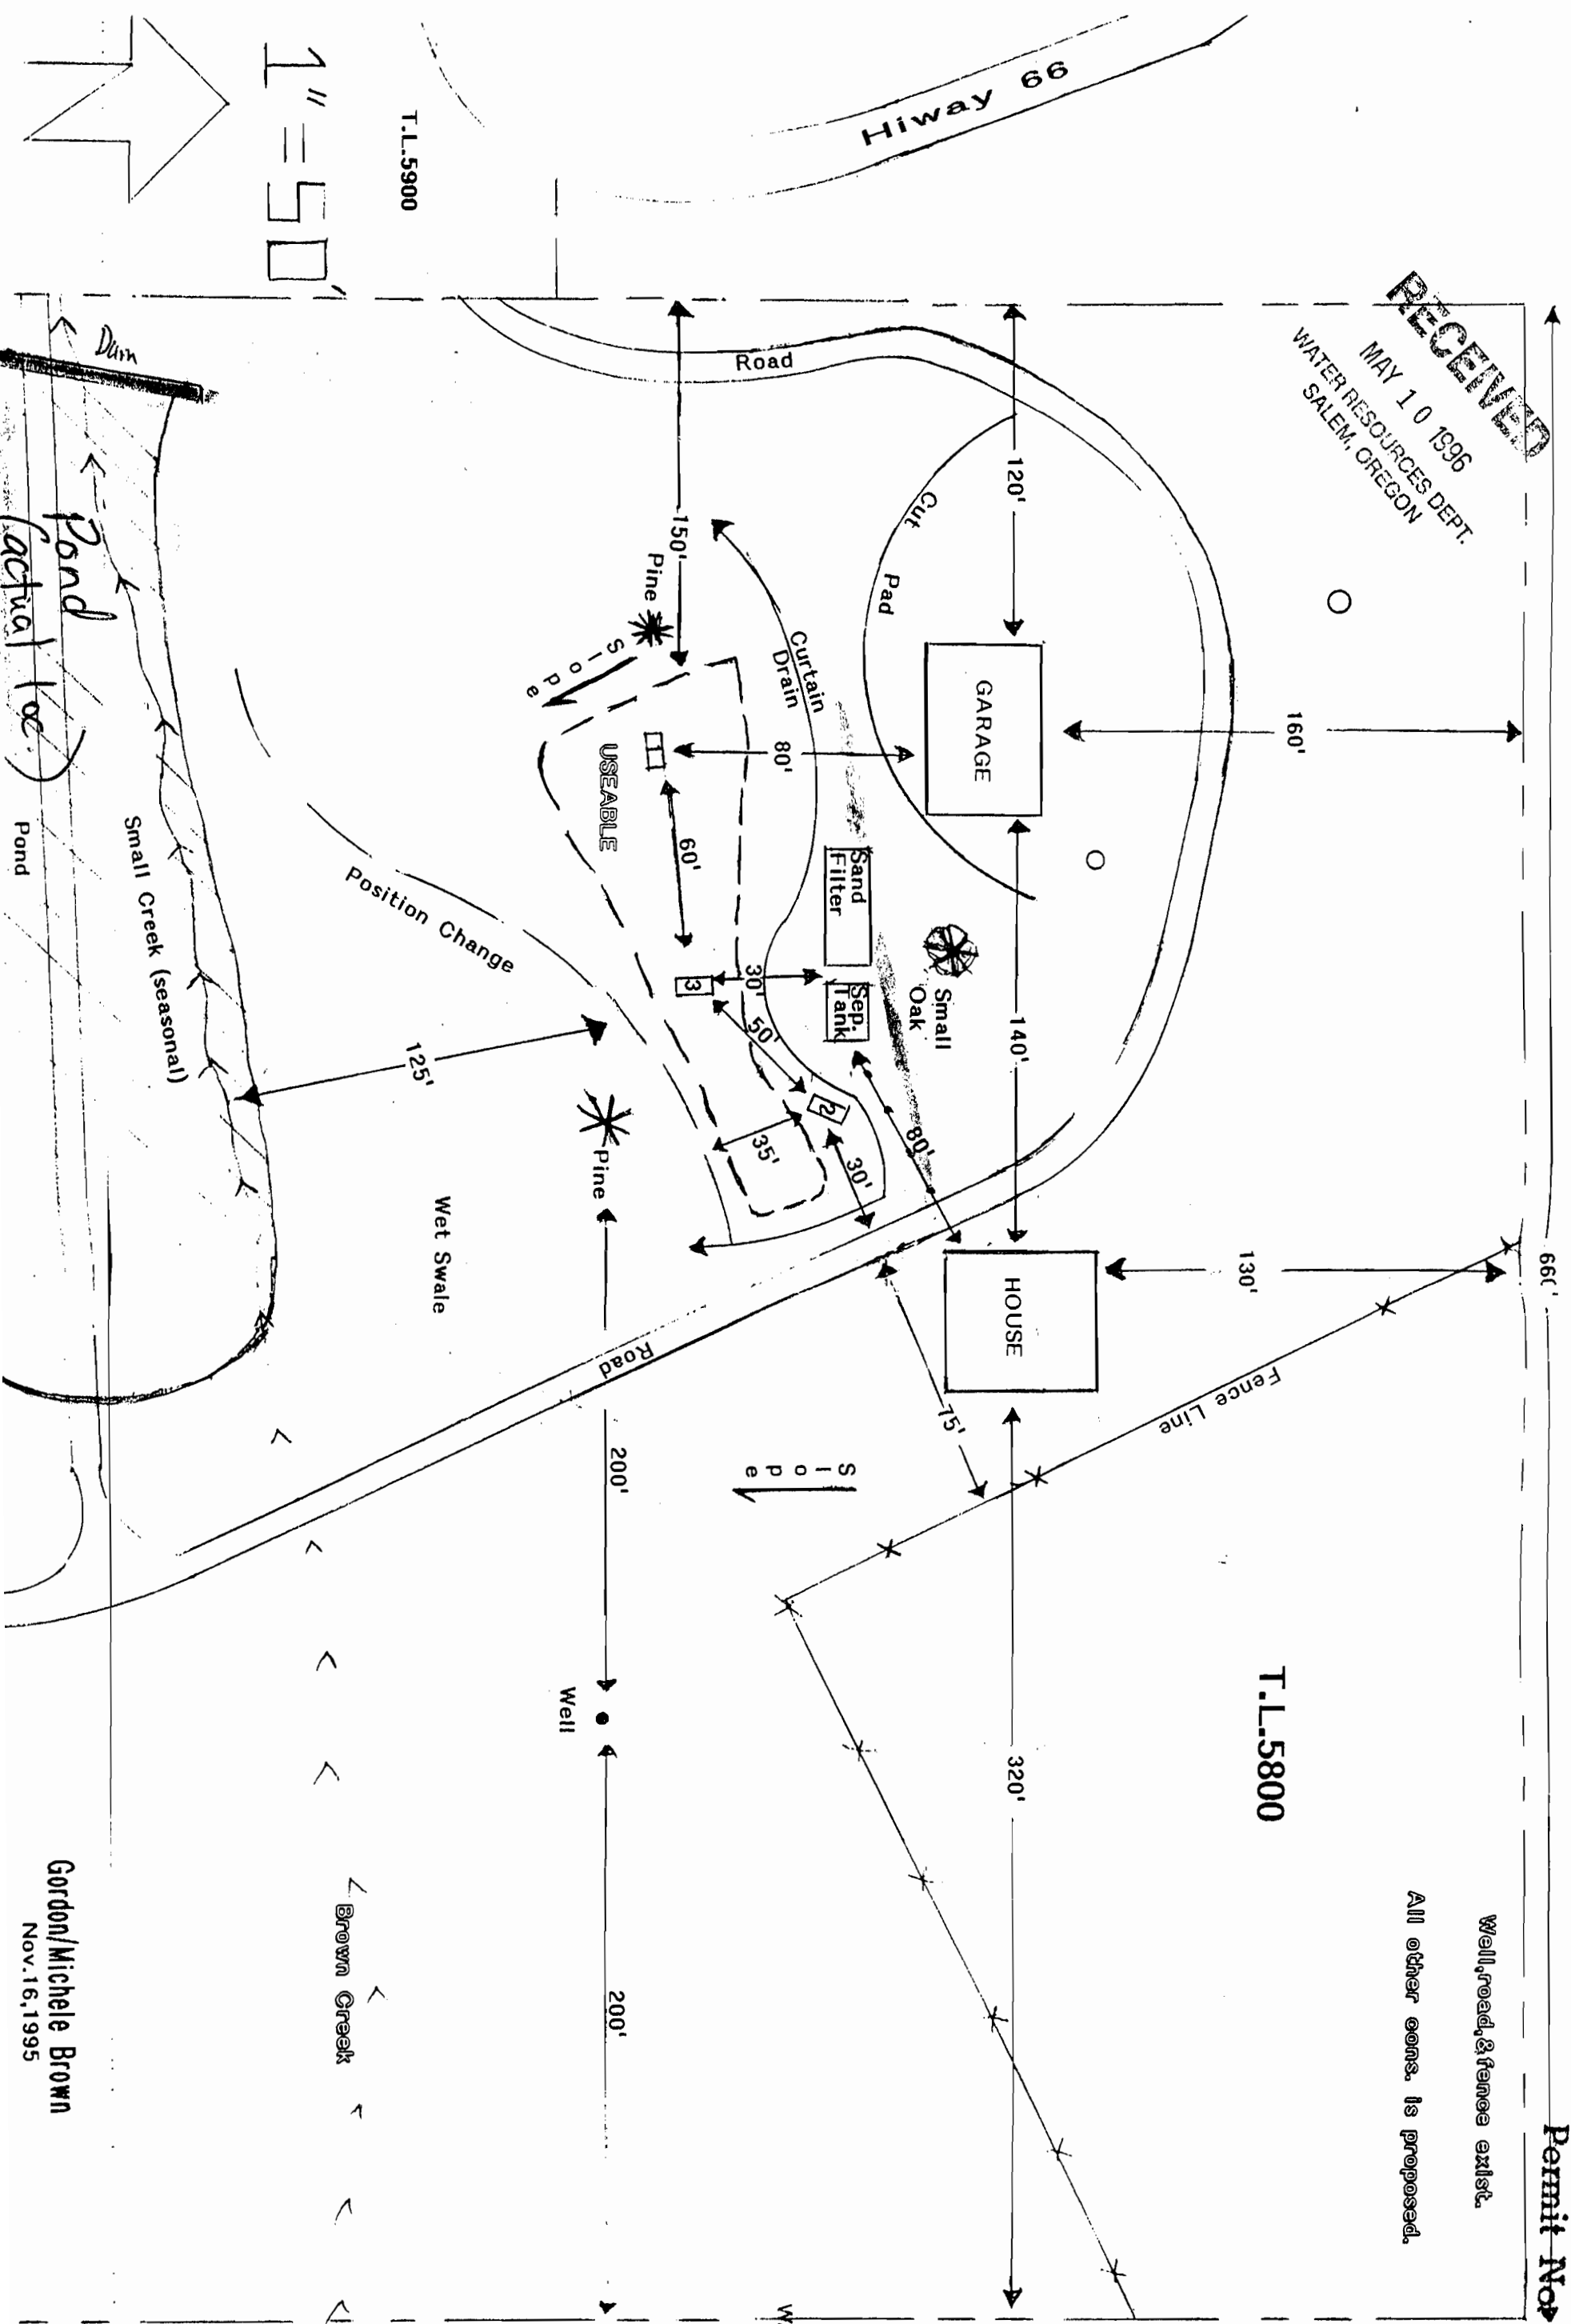

1"=50'

T.L.5900

Gordon/Michele Brown
Nov. 16, 1995

Spring
100 yds →
from old
T.L.