

Form AI-187
March 1961

UNITED STATES
DEPARTMENT OF THE INTERIOR
BUREAU OF LAND MANAGEMENT

SECTION


Oregon State Water Filings

S 1

TOWNSHIP 28 S, RANGE 41 E, W. M.

Lawyer Fort Cr. Res.

North

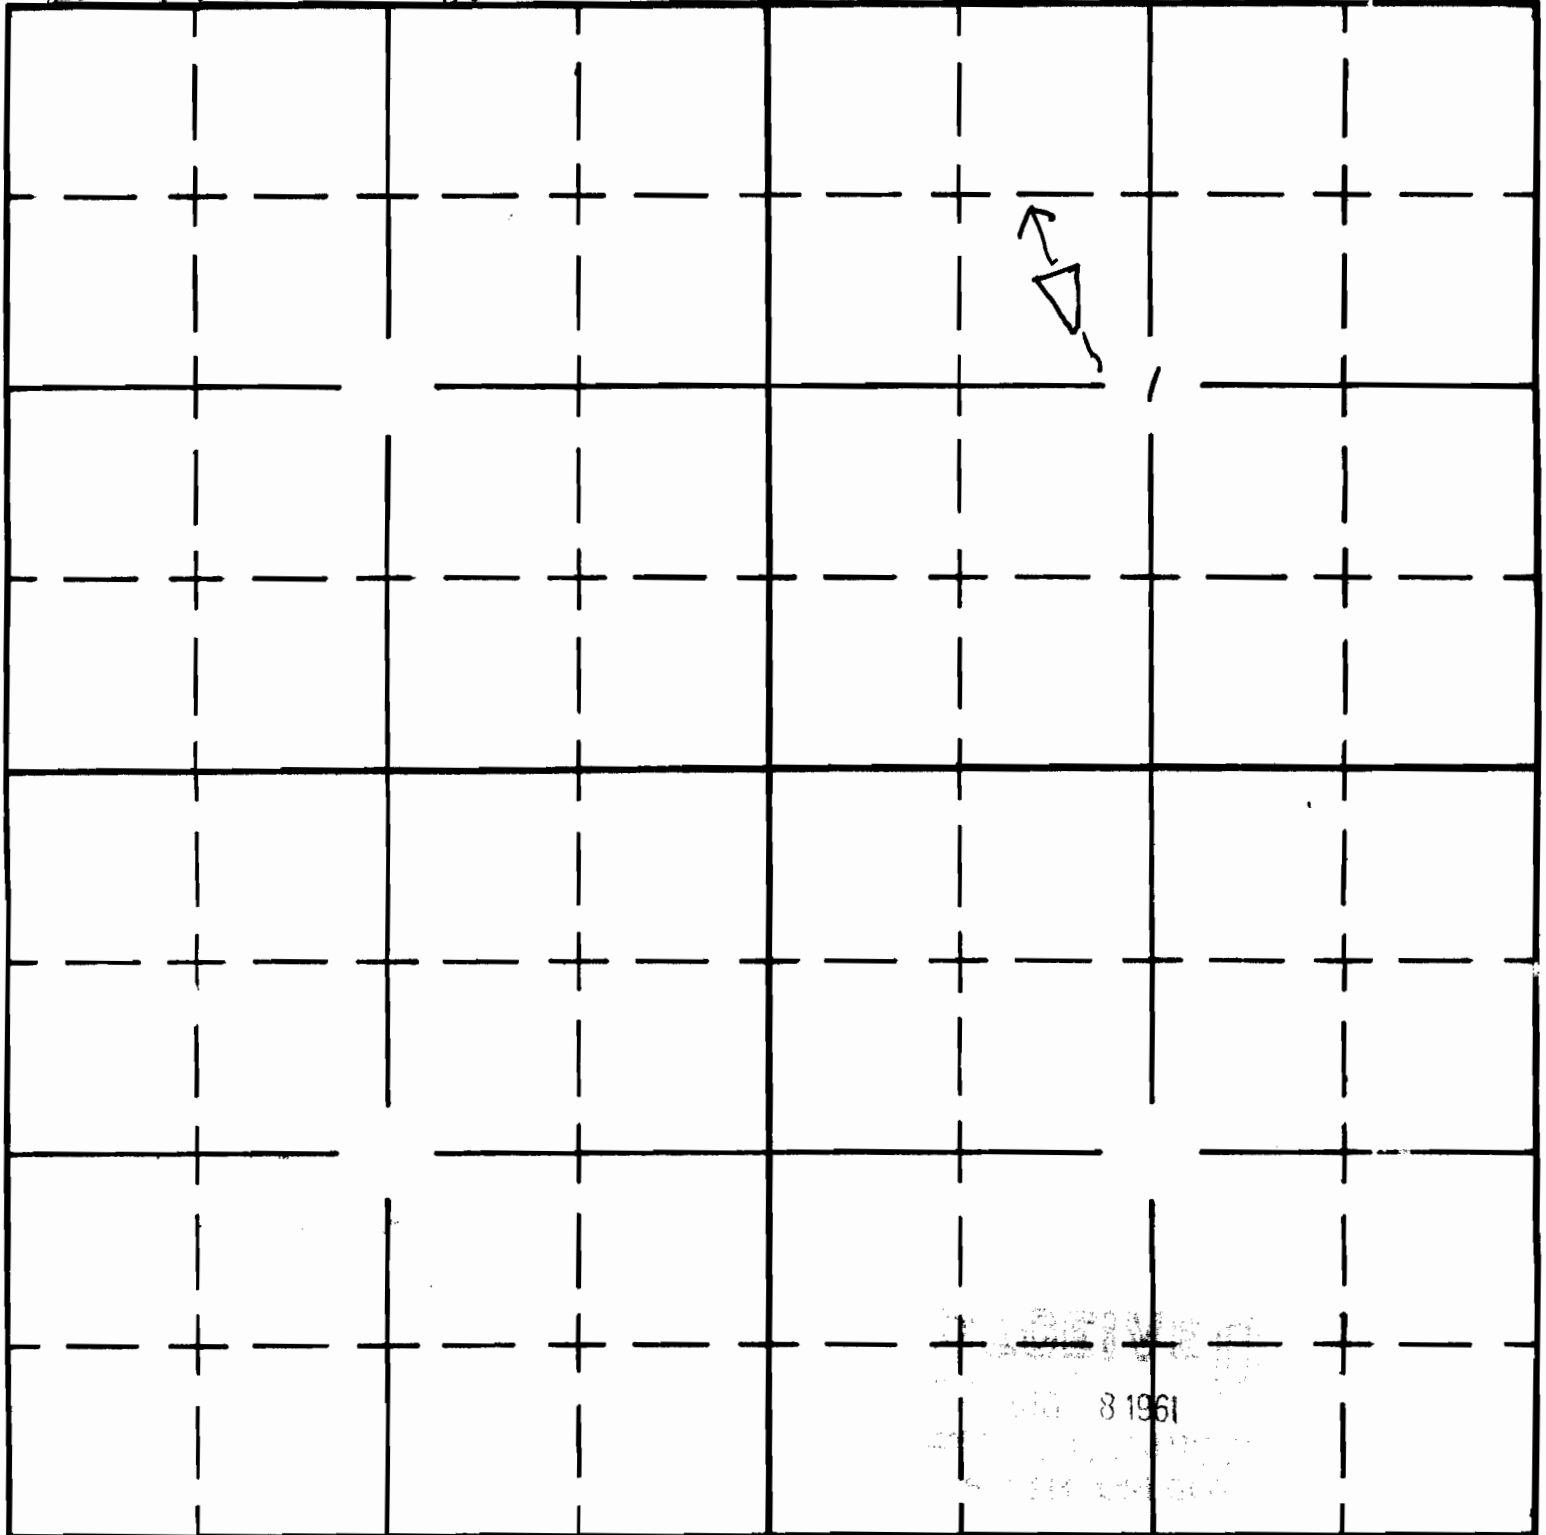

South

APPLICATION No. **R-36745**
PERMIT No. **R 7873**