

T. 26S., R. 33E., W.M.

FINAL PROOF SURVEY
UNDER


APPL. G-10258

PER. G-9324

IN NAME OF

HERB DAVIS & SONS

Surveyed 5-10, 1988 by B.S. JAMES

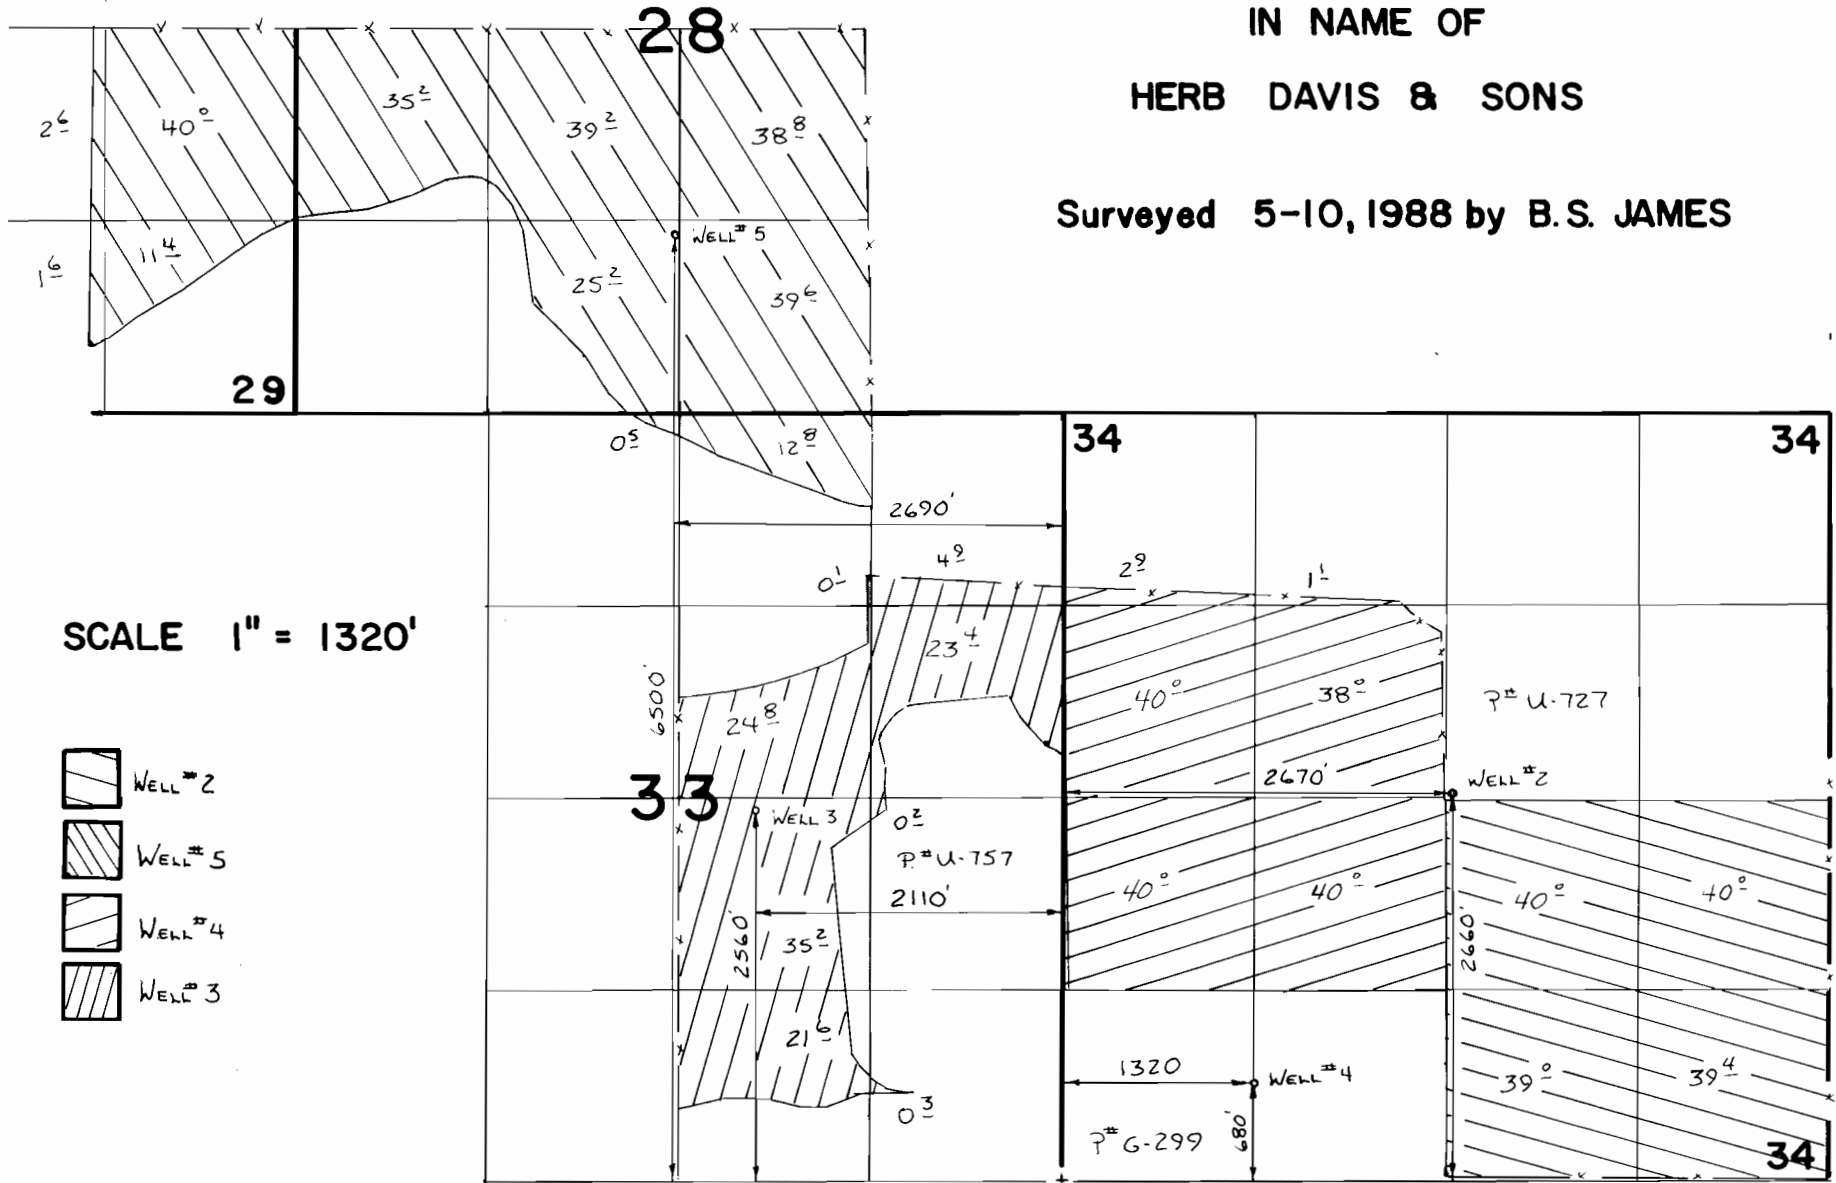

SCALE 1" = 1320'

-  WELL # 2
-  WELL # 5
-  WELL # 4
-  WELL # 3