



PRODUCED BY THE UNITED STATES GEOLOGICAL SURVEY
 CONTROL BY USGS, NOS/NOAA
 COMPILED FROM AERIAL PHOTOGRAPHS TAKEN 1982-83
 FIELD CHECKED 1982. MAP EDITED 1988
 PROJECTION LAMBERT CONFORMAL CONIC
 GRID: 1000-METER UNIVERSAL TRANSVERSE MERCATOR ZONE 10
 10,000-FOOT STATE GRID TICKS...OREG., S.ZONE/CALIF., ZONE 1
 UTM GRID DECLINATION 0°28' EAST
 1980 MAGNETIC NORTH DECLINATION 18°00' EAST
 VERTICAL DATUM ... NATIONAL GEODETIC VERTICAL DATUM OF 1929
 HORIZONTAL DATUM 1927 NORTH AMERICAN DATUM
 To place on the predicted North American Datum of 1983,
 move the projection lines as shown by dashed corner ticks
 (19 meters north / 94 meters east)
 There may be private inholdings within the boundaries of any
 Federal and State Reservations shown on this map
 No distinction made between houses, barns, and other buildings

PROVISIONAL MAP
 Produced from original
 manuscript drawings. Infor-
 mation shown as of date of
 photography.


THIS MAP COMPLIES WITH
 FOR SALE BY U. S. GEOLOGICAL SURVEY.

[Scale = 1:24000]

CERTIFICATE NO. 71454

Application No 76883
 Permit No. R-79254

PARKER MOUNTAIN Quad.

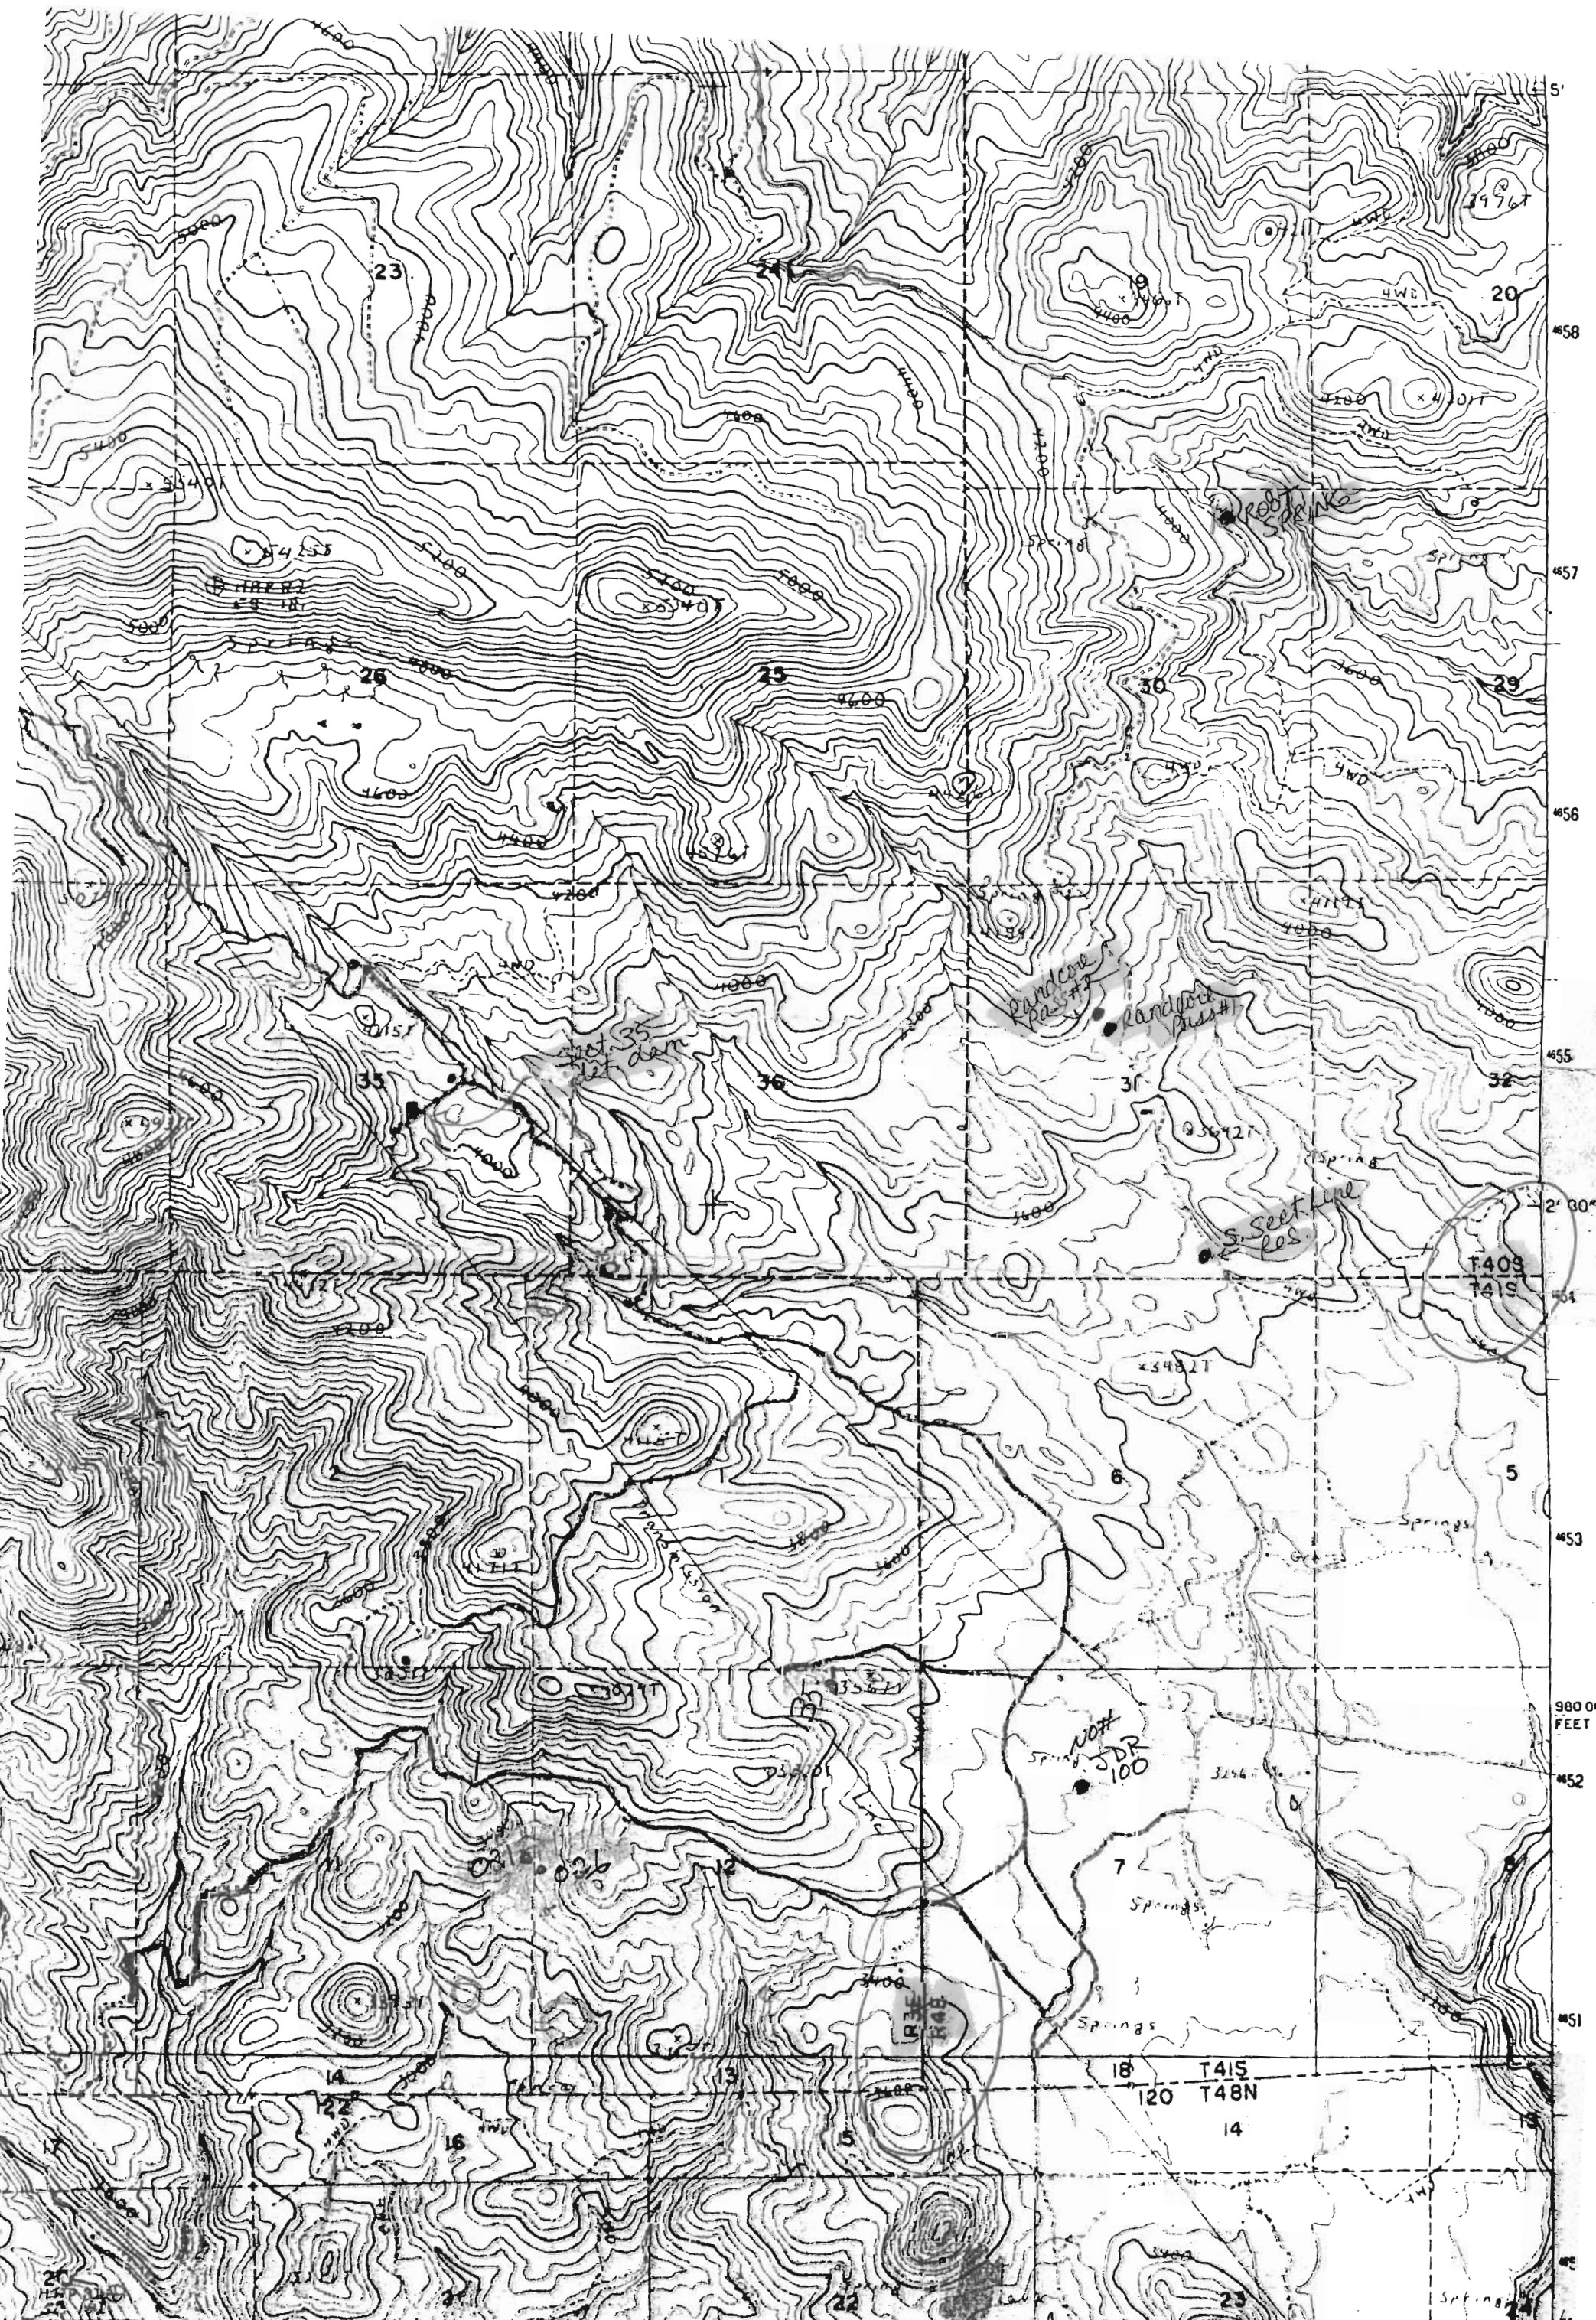

Application No. R-79254
Permit No. [Scale = 1:24000]
Hyatt Reservoir SW Quad
SODA MTN QUAD PAN 51E