


T. 9 S., R. 3 E., WM



10

11

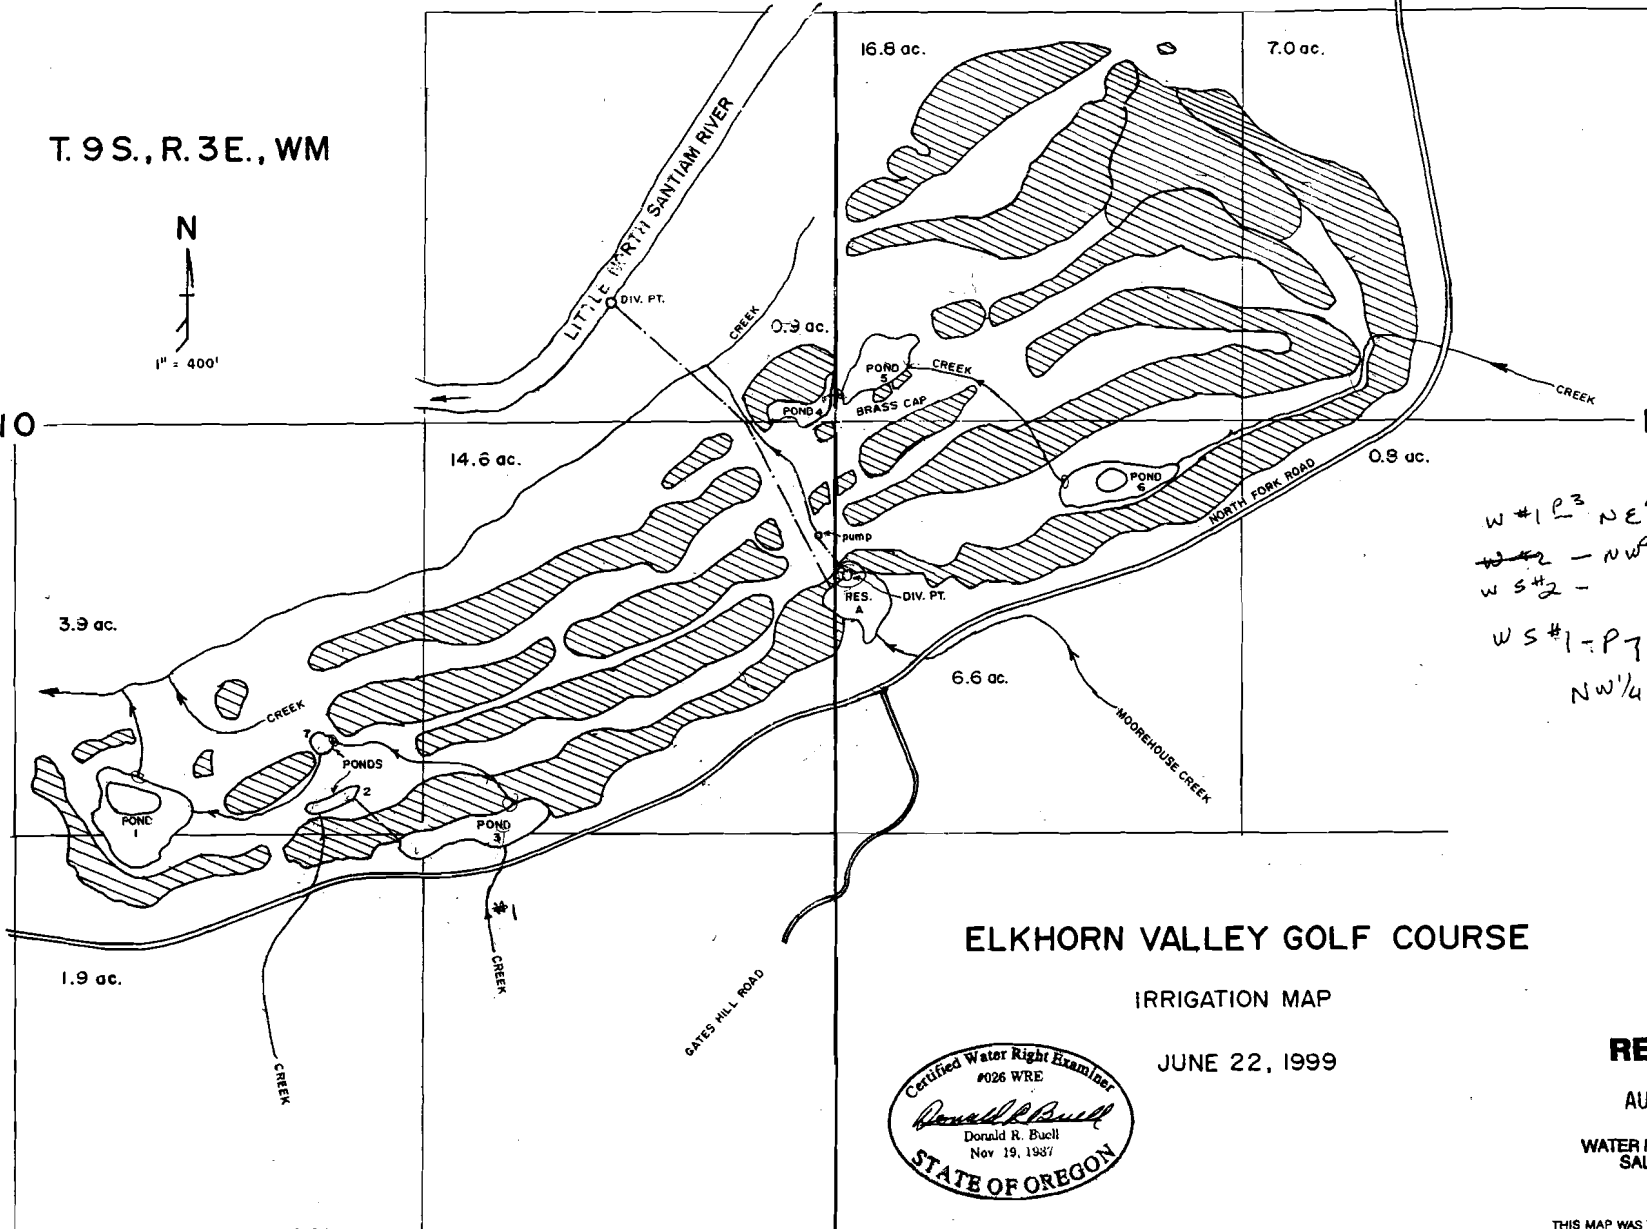

W #1 P³ NE⁴ SE⁴ Sec 10
W #2 - NW⁴ SE⁴ Sec 10
W S #2 -
W S #1 - P⁷ P¹
NW¹/₄ SE¹/₄

ELKHORN VALLEY GOLF COURSE

IRRIGATION MAP

JUNE 22, 1999



RECEIVED

AUG 3 0 2000

WATER RESOURCES DEPT.
SALEM, OREGON

CREEK LOCATIONS AWAY FROM COURSE APPROX.

THIS MAP WAS PREPARED FOR THE PURPOSE OF IDENTIFYING THE LOCATION OF A WATER RIGHT ONLY AND IS NOT INTENDED TO PROVIDE LEGAL DIMENSIONS OR LOCATION OF PROPERTY OWNERSHIP LINES.