11526

Sec. 8

Tp 8 S

R. 30 E.

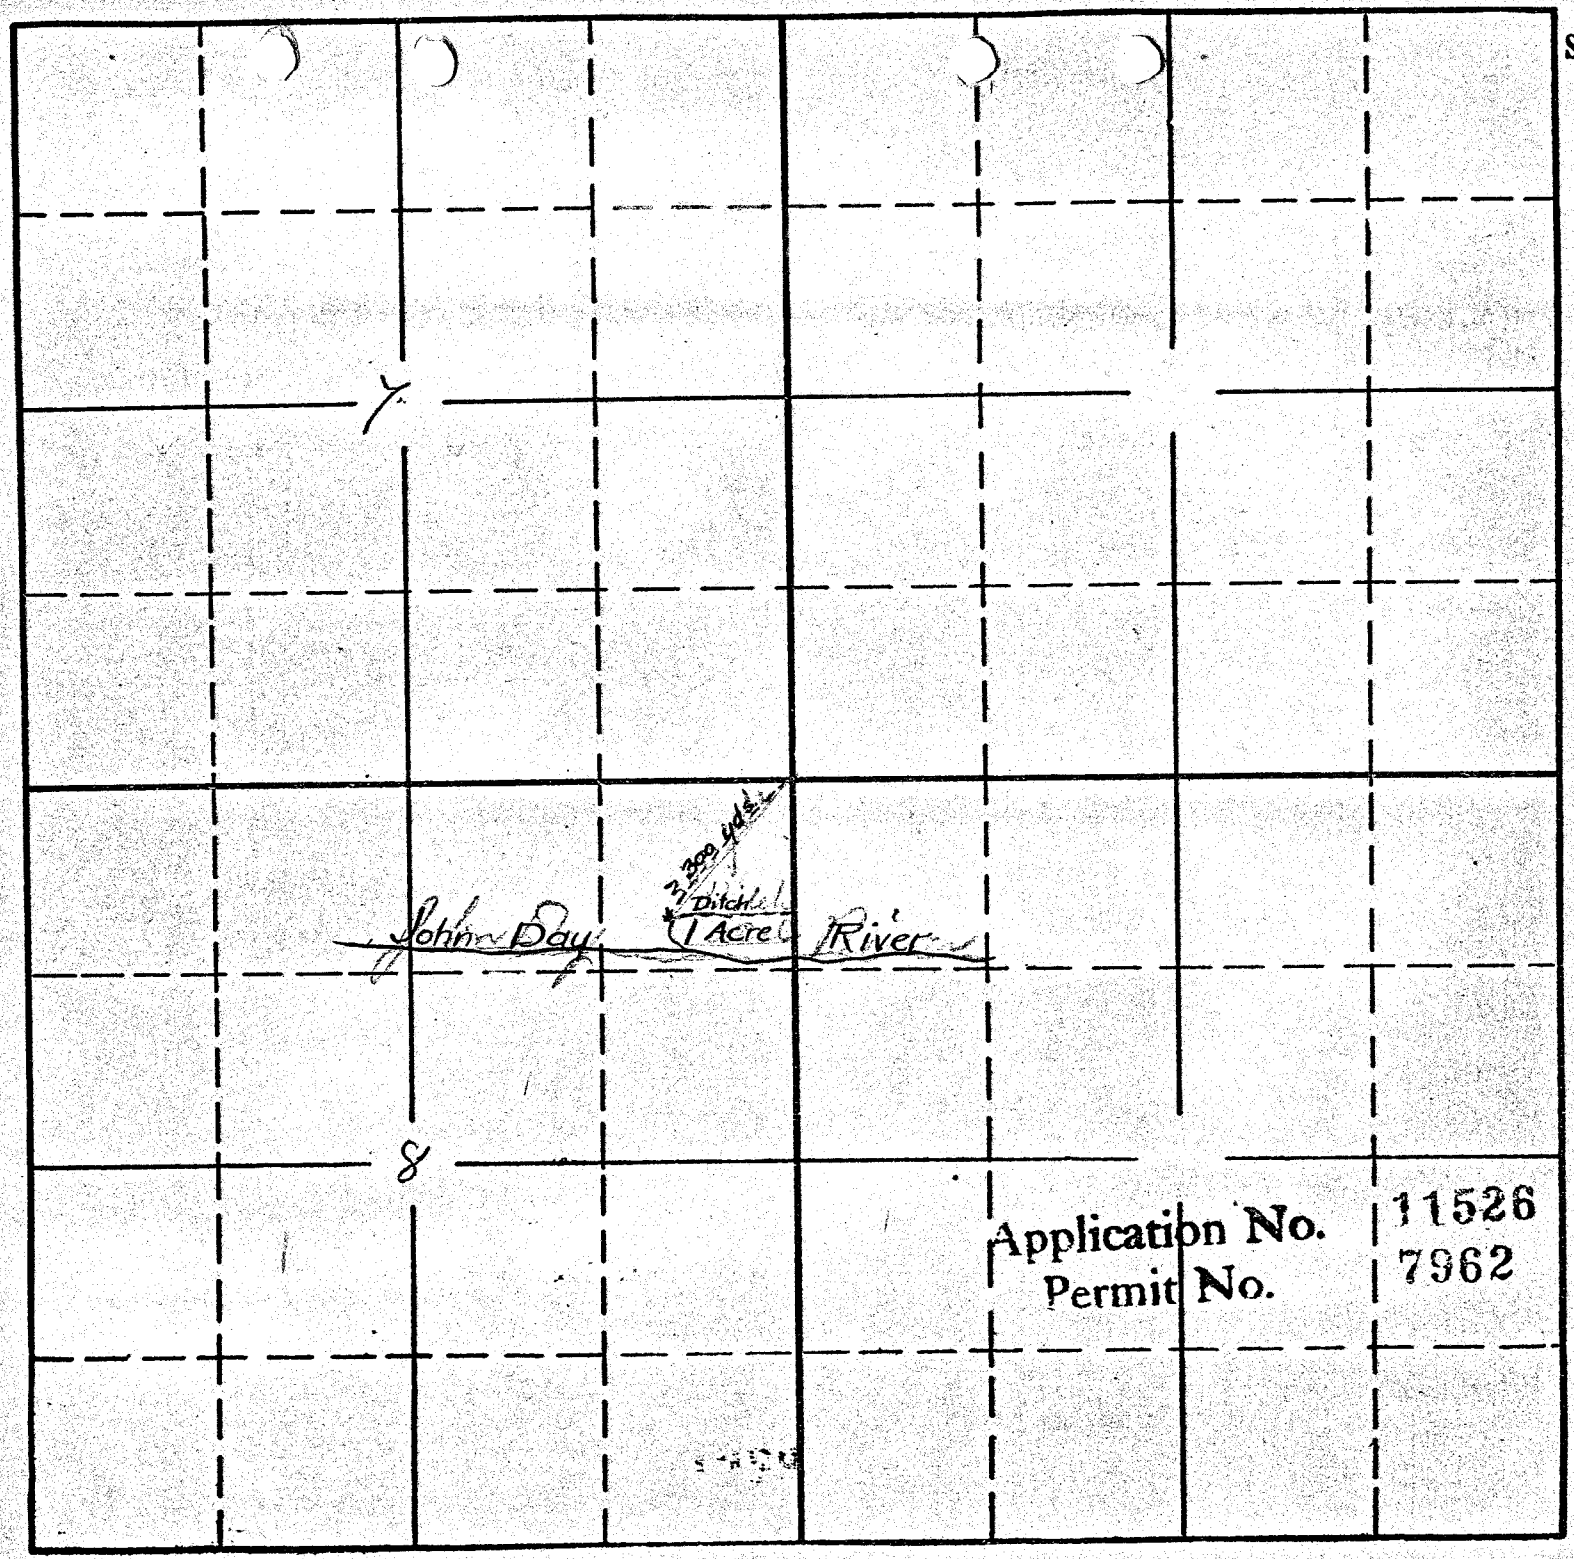

Application No. 11526
Permit No. 7962

Per 7962
7691