


T.5S.R.5W.W.M.

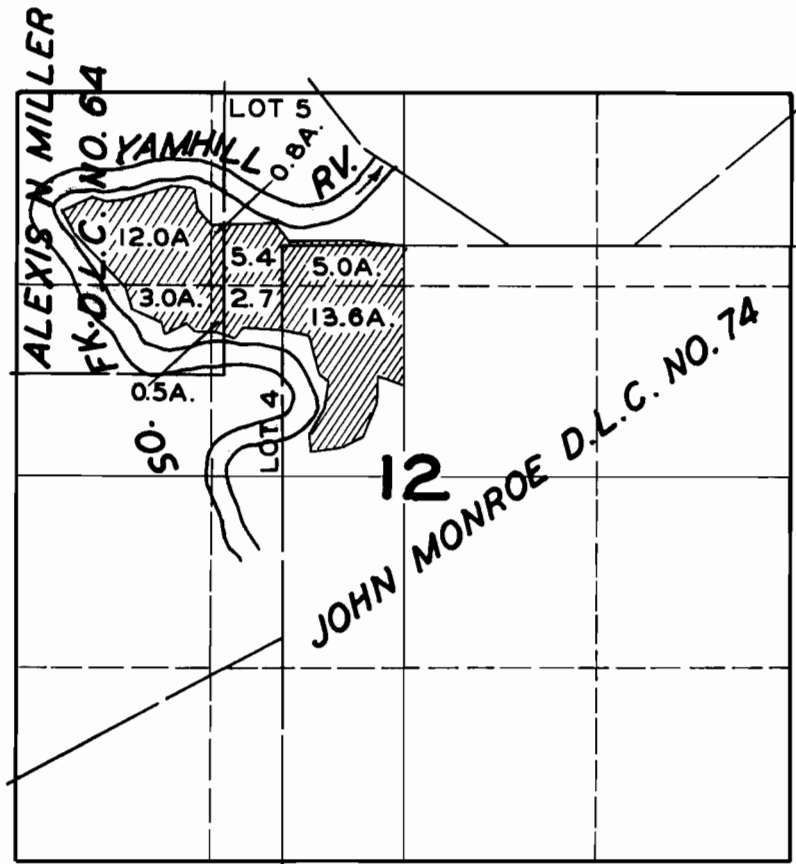

FINAL PROOF SURVEY

UNDER

Application No. **23026** Permit No. **18197**.....

IN NAME OF

CHESTER L. MULKEY.....

Surveyed **AUG. 20 1948** by **JAS. E. BUNNELL**