


Per# 8025
7692

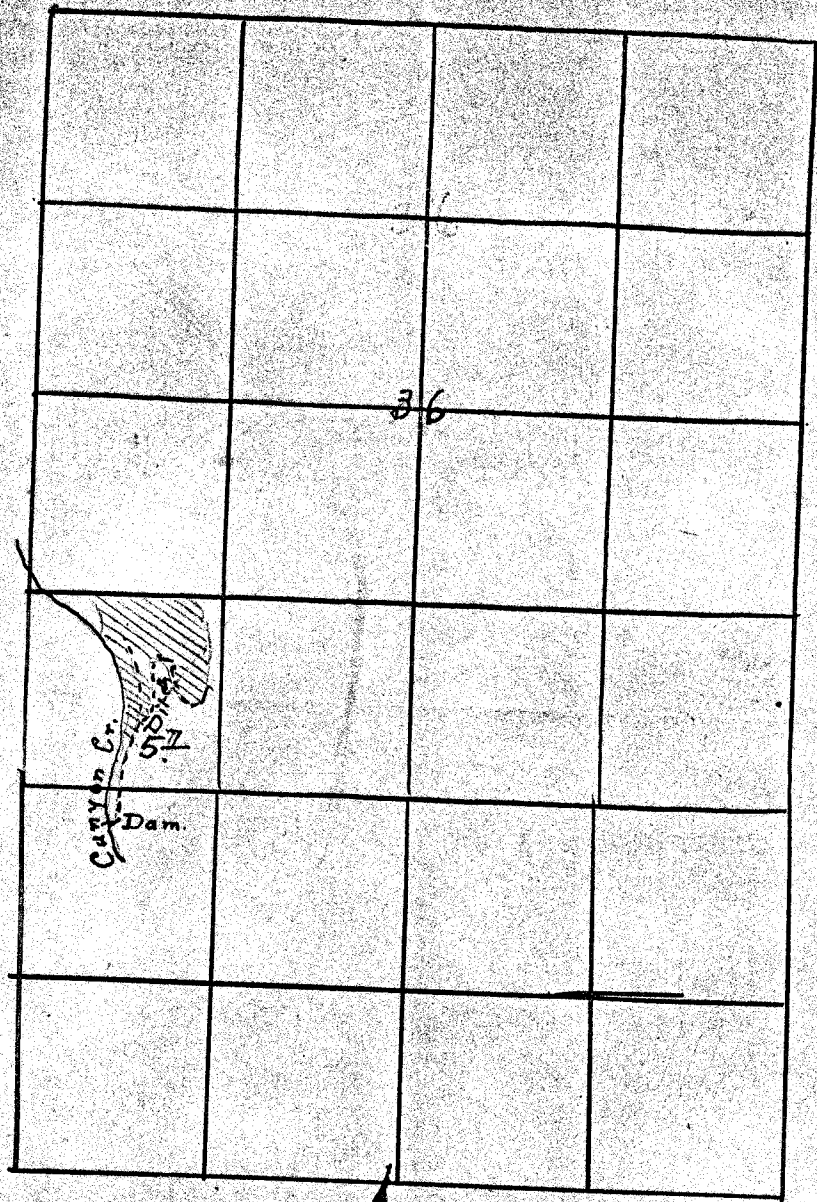

Sec. 36 T. 14 S. R. 31 E. & N $\frac{1}{2}$ Sec. 1 T. 15 S. R. 31 E.

To accompany Claim of Mary Hall, Canyon City, Ore.

Application No. 11582
Permit No. 8025