


T. 34 S., R. 1 W., W.M

SEC. 21

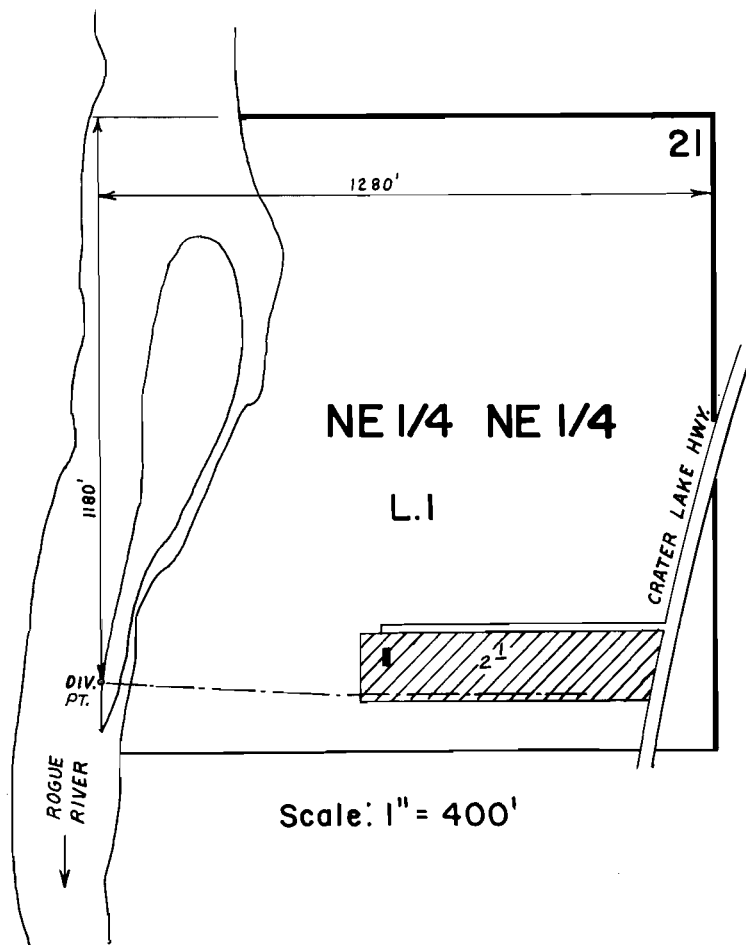

FINAL PROOF SURVEY
UNDER

Application No. **54417** Permit No. **40805**
IN NAME OF

NEVIN H. JENSEN

Surveyed **JUNE 24 1983**, by **B. S. JAMES**