T.38S.,R.3W.,W.M.

RECEIVED
OCT 0 9 2003
WATER RESOURCES DEPT.
SALEM, OREGON

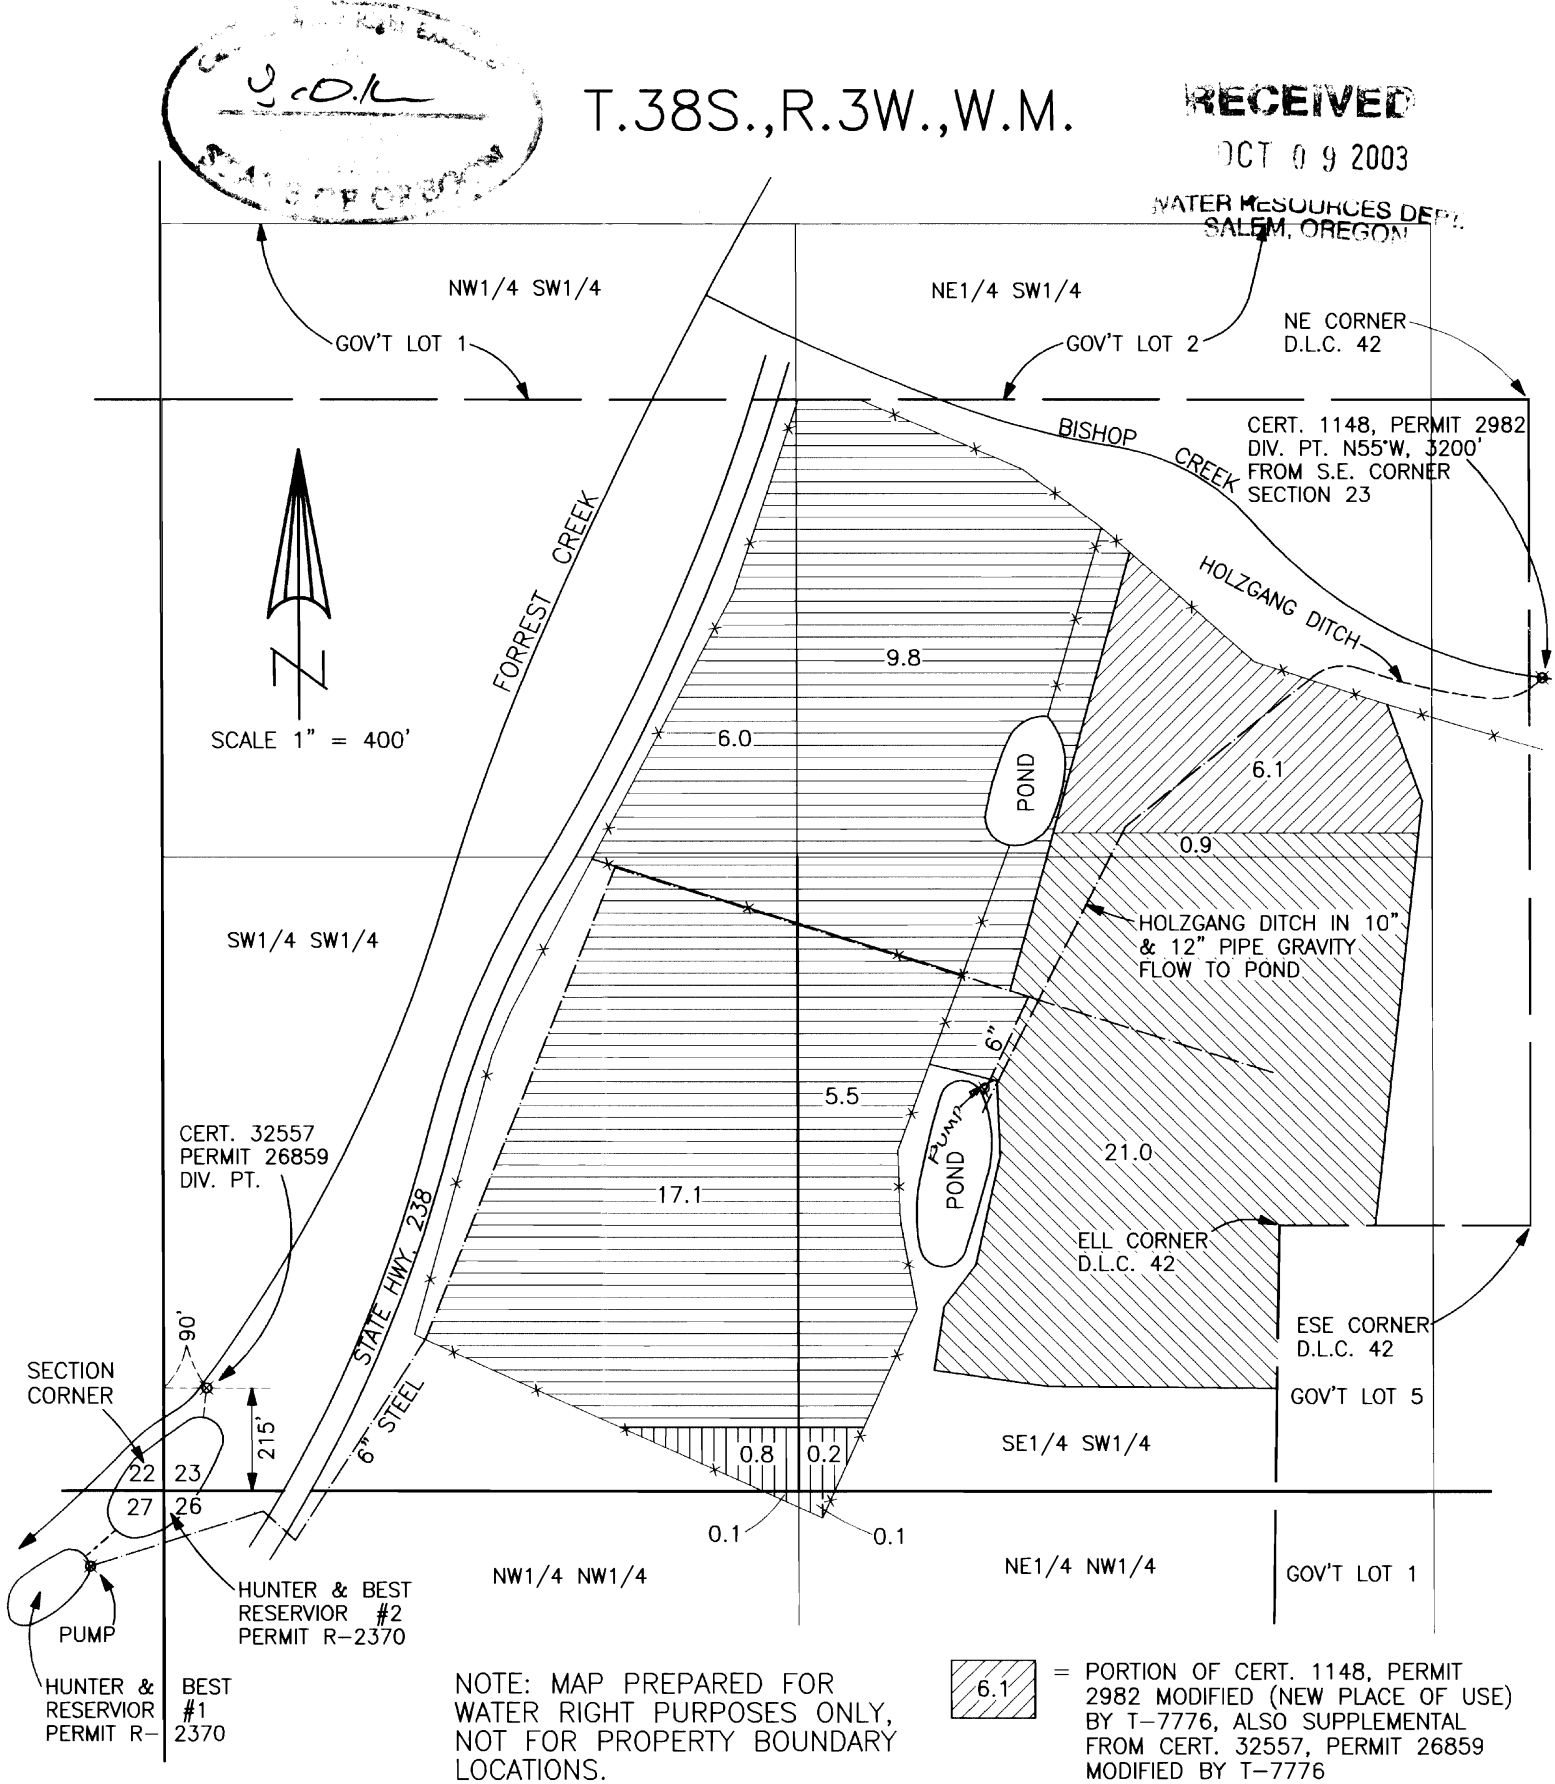

NOTE: MAP PREPARED FOR WATER RIGHT PURPOSES ONLY, NOT FOR PROPERTY BOUNDARY LOCATIONS.

6.1 = PORTION OF CERT. 1148, PERMIT 2982 MODIFIED (NEW PLACE OF USE) BY T-7776, ALSO SUPPLEMENTAL FROM CERT. 32557, PERMIT 26859 MODIFIED BY T-7776

21.9 = PORTION OF CERT. 32557, PERMIT 26859 MODIFIED (NEW PLACE OF USE) BY T-7776

38.4 = PORTION OF CERT. 1148, PERMIT 2982, NO CHANGE

1.2 = PORTION OF CERT. 32557, PERMIT 26859, NO CHANGE

CLAIM OF BENEFICIAL USE MAP

APPLICATION No. T-7776

IN THE NAME OF
APPLEGATE INVESTMENTS, INC. (BILLY JOE HUNTER)

MAP PREPARED SEPTEMBER 26, 2003 BY GARY D. KAISER