


11384

Sec.

Tp. 105.

R. 31 E.

Per 8057
7693

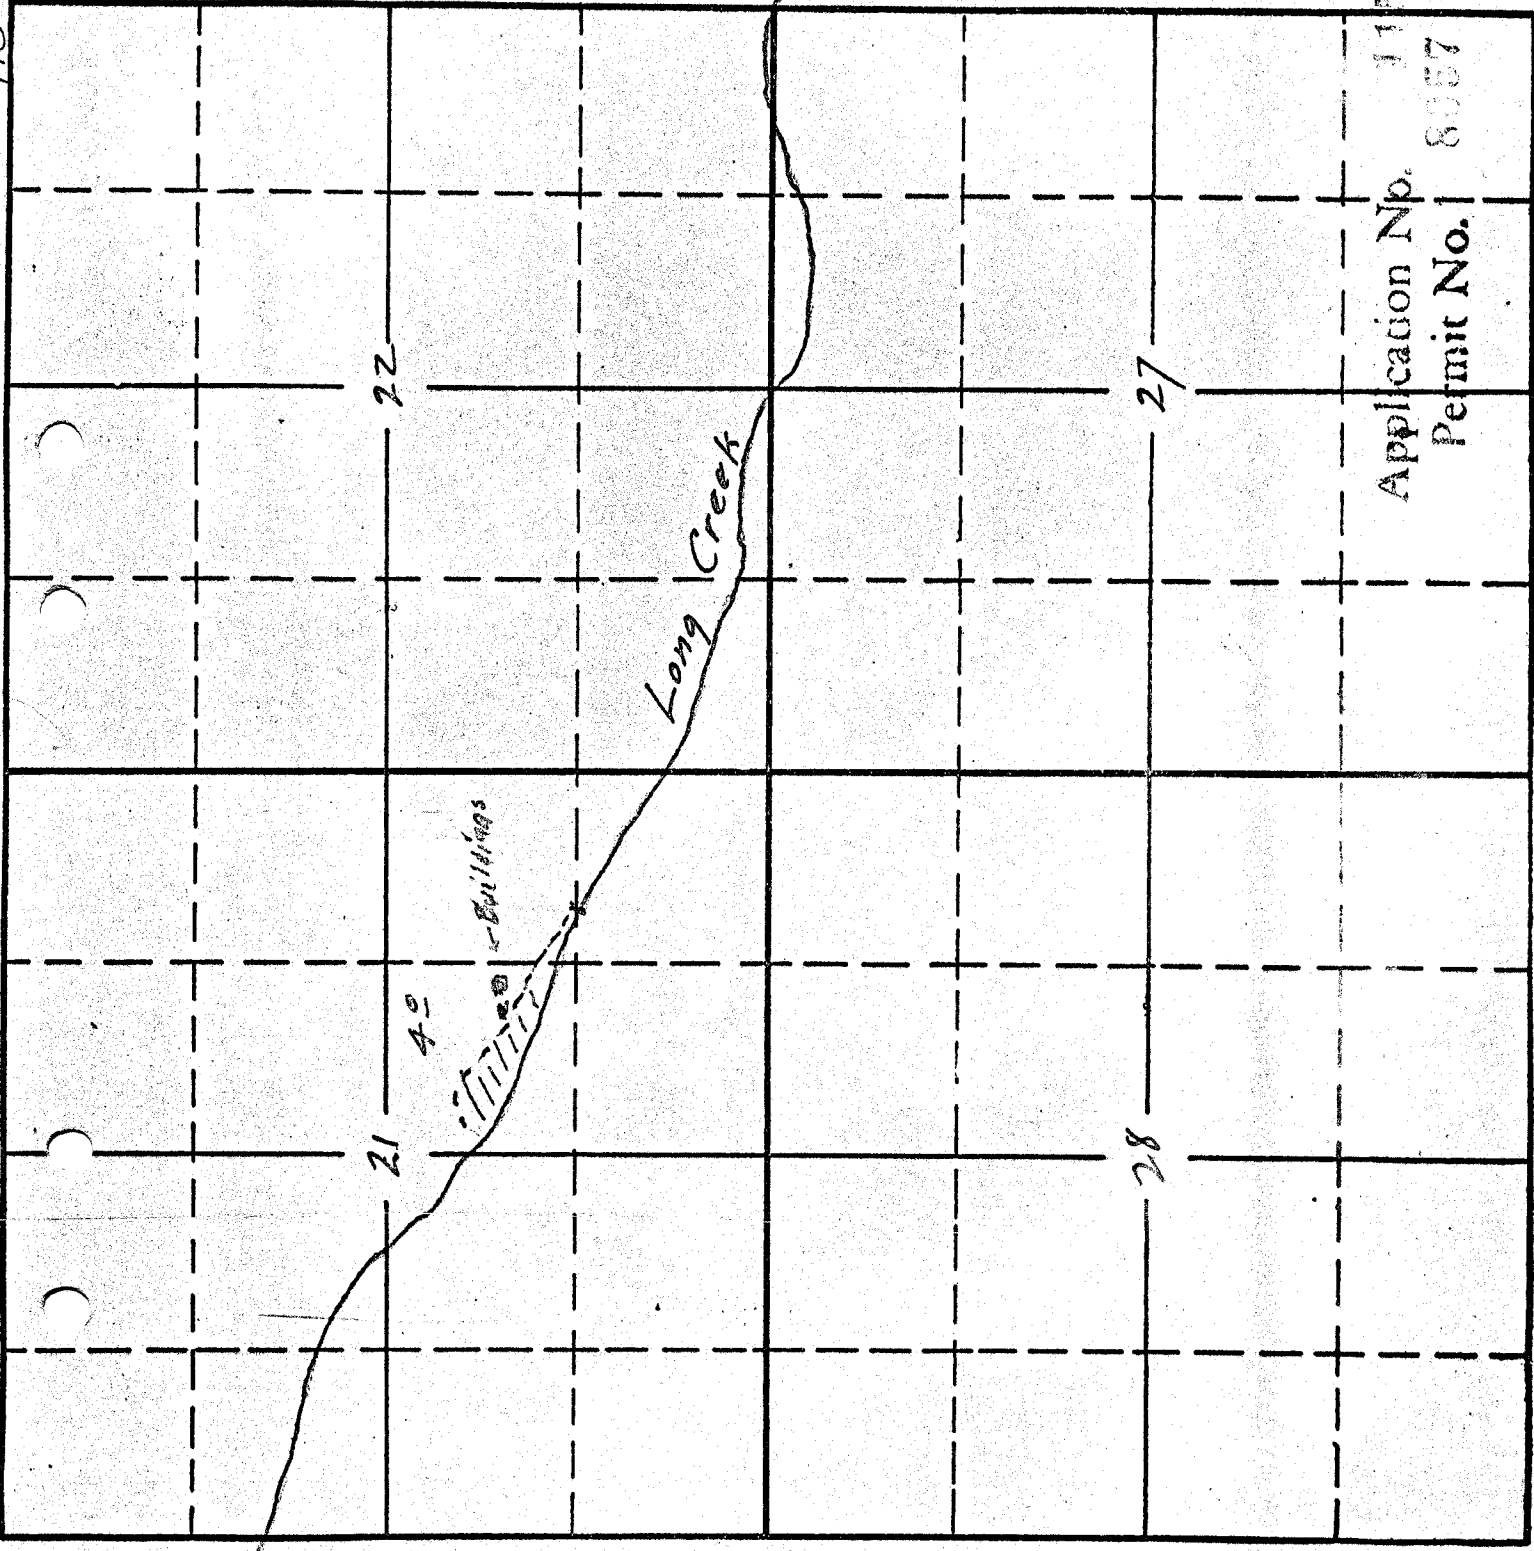

MAP
to accompany
Application
of
Harold Laab

Application No. 11589
Permit No. 8057