


T. 34 S. R. 1 & 2 W. W. M.

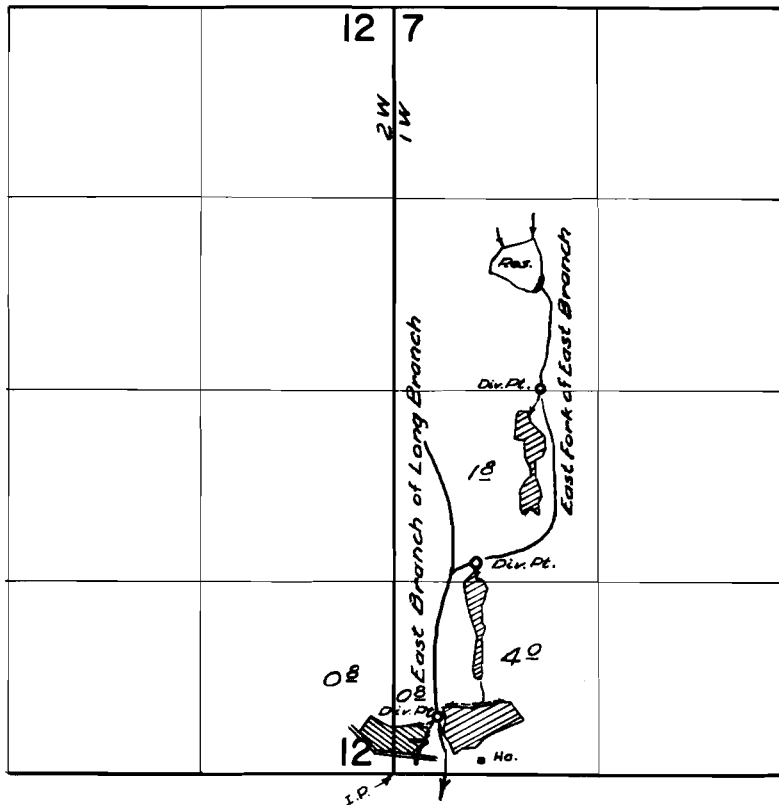

FINAL PROOF SURVEY UNDER

Application No. 22413 Permit No. 17705
R-22412 R.879
IN NAME OF

Surveyed 14 APRIL 1960, by M. B. Bish