COP

T. 11 S. R. 4 W. W. M.

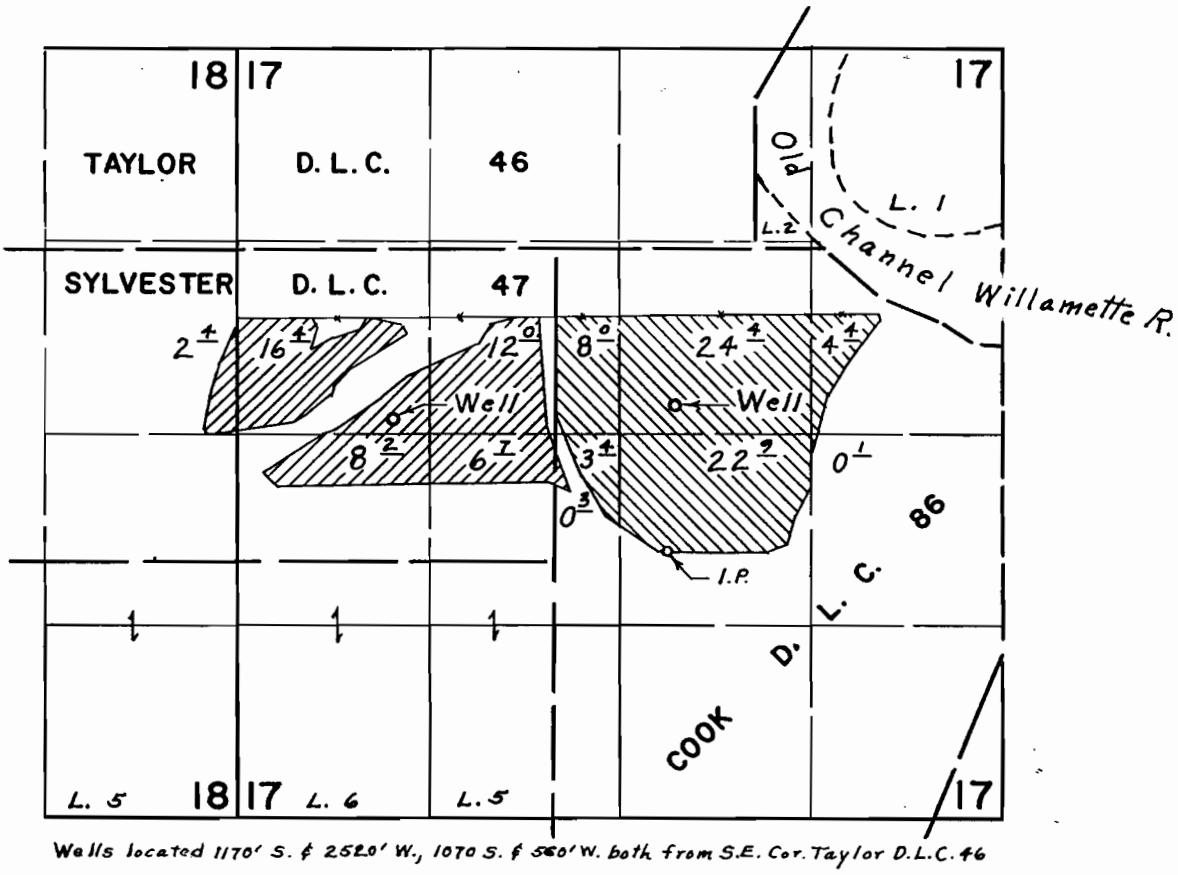

Wells located 1170' S. & 2520' W., 1070 S. & 560' W. both from S.E. Cor. Taylor D.L.C. 46

FINAL PROOF SURVEY
UNDER

Application No. G-3552 Permit No. G-3341
IN NAME OF

BEN & HAZEL O. ELLIS

Surveyed Aug. 11, 1969, by L. E. Gould

1969-Y