

MAY 2 6 1998

FINAL PROOF SURVEY MAP

WATER RESOURCES DEPT. SALEM, OREGON


IN THE NAME OF GARY SOLMI

SECTIONS 1 & 12, TOWNSHIP 24 SOUTH, RANGE 7 WEST, W.M.

APPLICATION R-74512

PERMIT R-11951

APPLICATION S-74513 PERMIT 52671

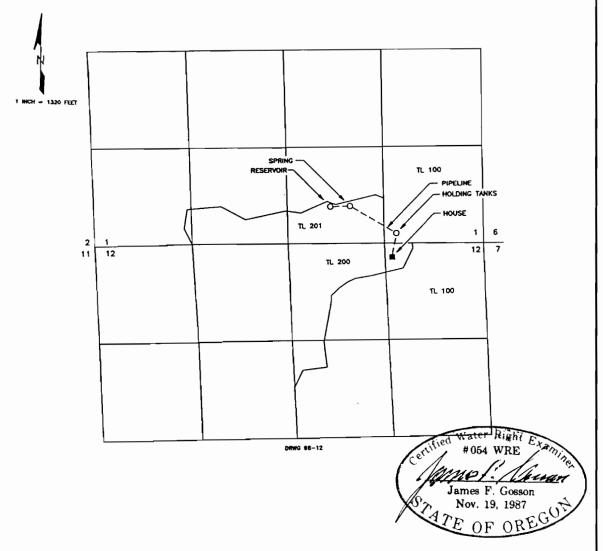

THE POINT OF DIVERSION IS LOCATED 500 FEET NORTH AND 1830 FEET WEST FROM THE SOUTHEAST CORNER OF SECTION 1, BEING WITHIN THE SW1/4 SE1/4 OF SECTION 1, TOWNSHIP 24 SOUTH, RANGE 7 WEST, W.M., DOUGLAS COUNTY.

THE PURPOSE OF THIS MAP IS TO IDENTIFY THE LOCATION OF THE WATER RIGHT. IT IS NOT INTENDED TO PROVIDE INFORMATION RELATIVE TO THE LOCATION OF PROPERTY OWNERSHIP BOUNDARY LINES.