

RECEIVED

MAY 26 1998

WATER RESOURCES DEPT.
SALEM, OREGON

FINAL PROOF SURVEY MAP

IN THE NAME OF GARY SOLMI


SECTIONS 1 & 12, TOWNSHIP 24 SOUTH, RANGE 7 WEST, W.M.

APPLICATION R-74512


PERMIT R-11951

APPLICATION S-74513

PERMIT 52671

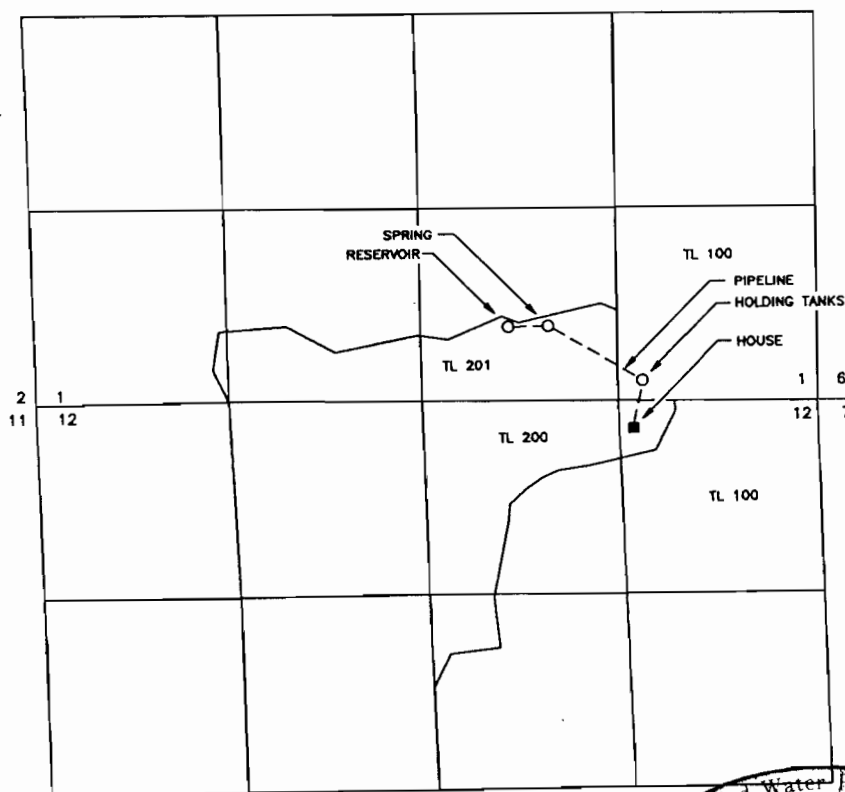

DRWG 98-12

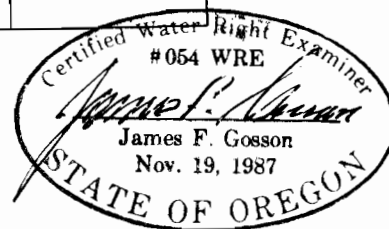

THE POINT OF DIVERSION IS LOCATED 500 FEET NORTH AND 1830 FEET WEST FROM THE SOUTHEAST CORNER OF SECTION 1, BEING WITHIN THE SW1/4 SE1/4 OF SECTION 1, TOWNSHIP 24 SOUTH, RANGE 7 WEST, W.M., DOUGLAS COUNTY.

THE PURPOSE OF THIS MAP IS TO IDENTIFY THE LOCATION OF THE WATER RIGHT. IT IS NOT INTENDED TO PROVIDE INFORMATION RELATIVE TO THE LOCATION OF PROPERTY OWNERSHIP BOUNDARY LINES.