
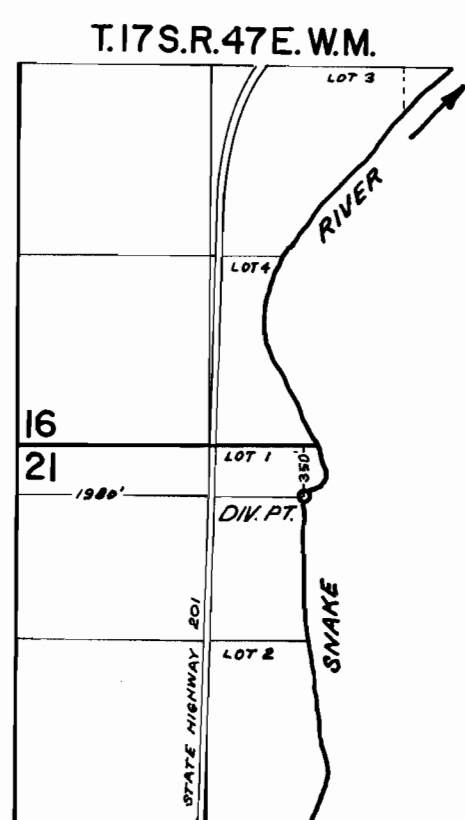


T.17&18S.R.46E.W.M.

- PRIMARY IRRIGATION - MALHEUR RIVER
  - PERMIT No. 30621
  - PERMIT No. 33946
- PRIMARY IRRIGATION - SNAKE RIVER
  - PERMIT No. 31231
  - PERMIT No. 33944
- SUPPLEMENTAL IRRIGATION - SNAKE RIVER
  - PERMIT No. 33945

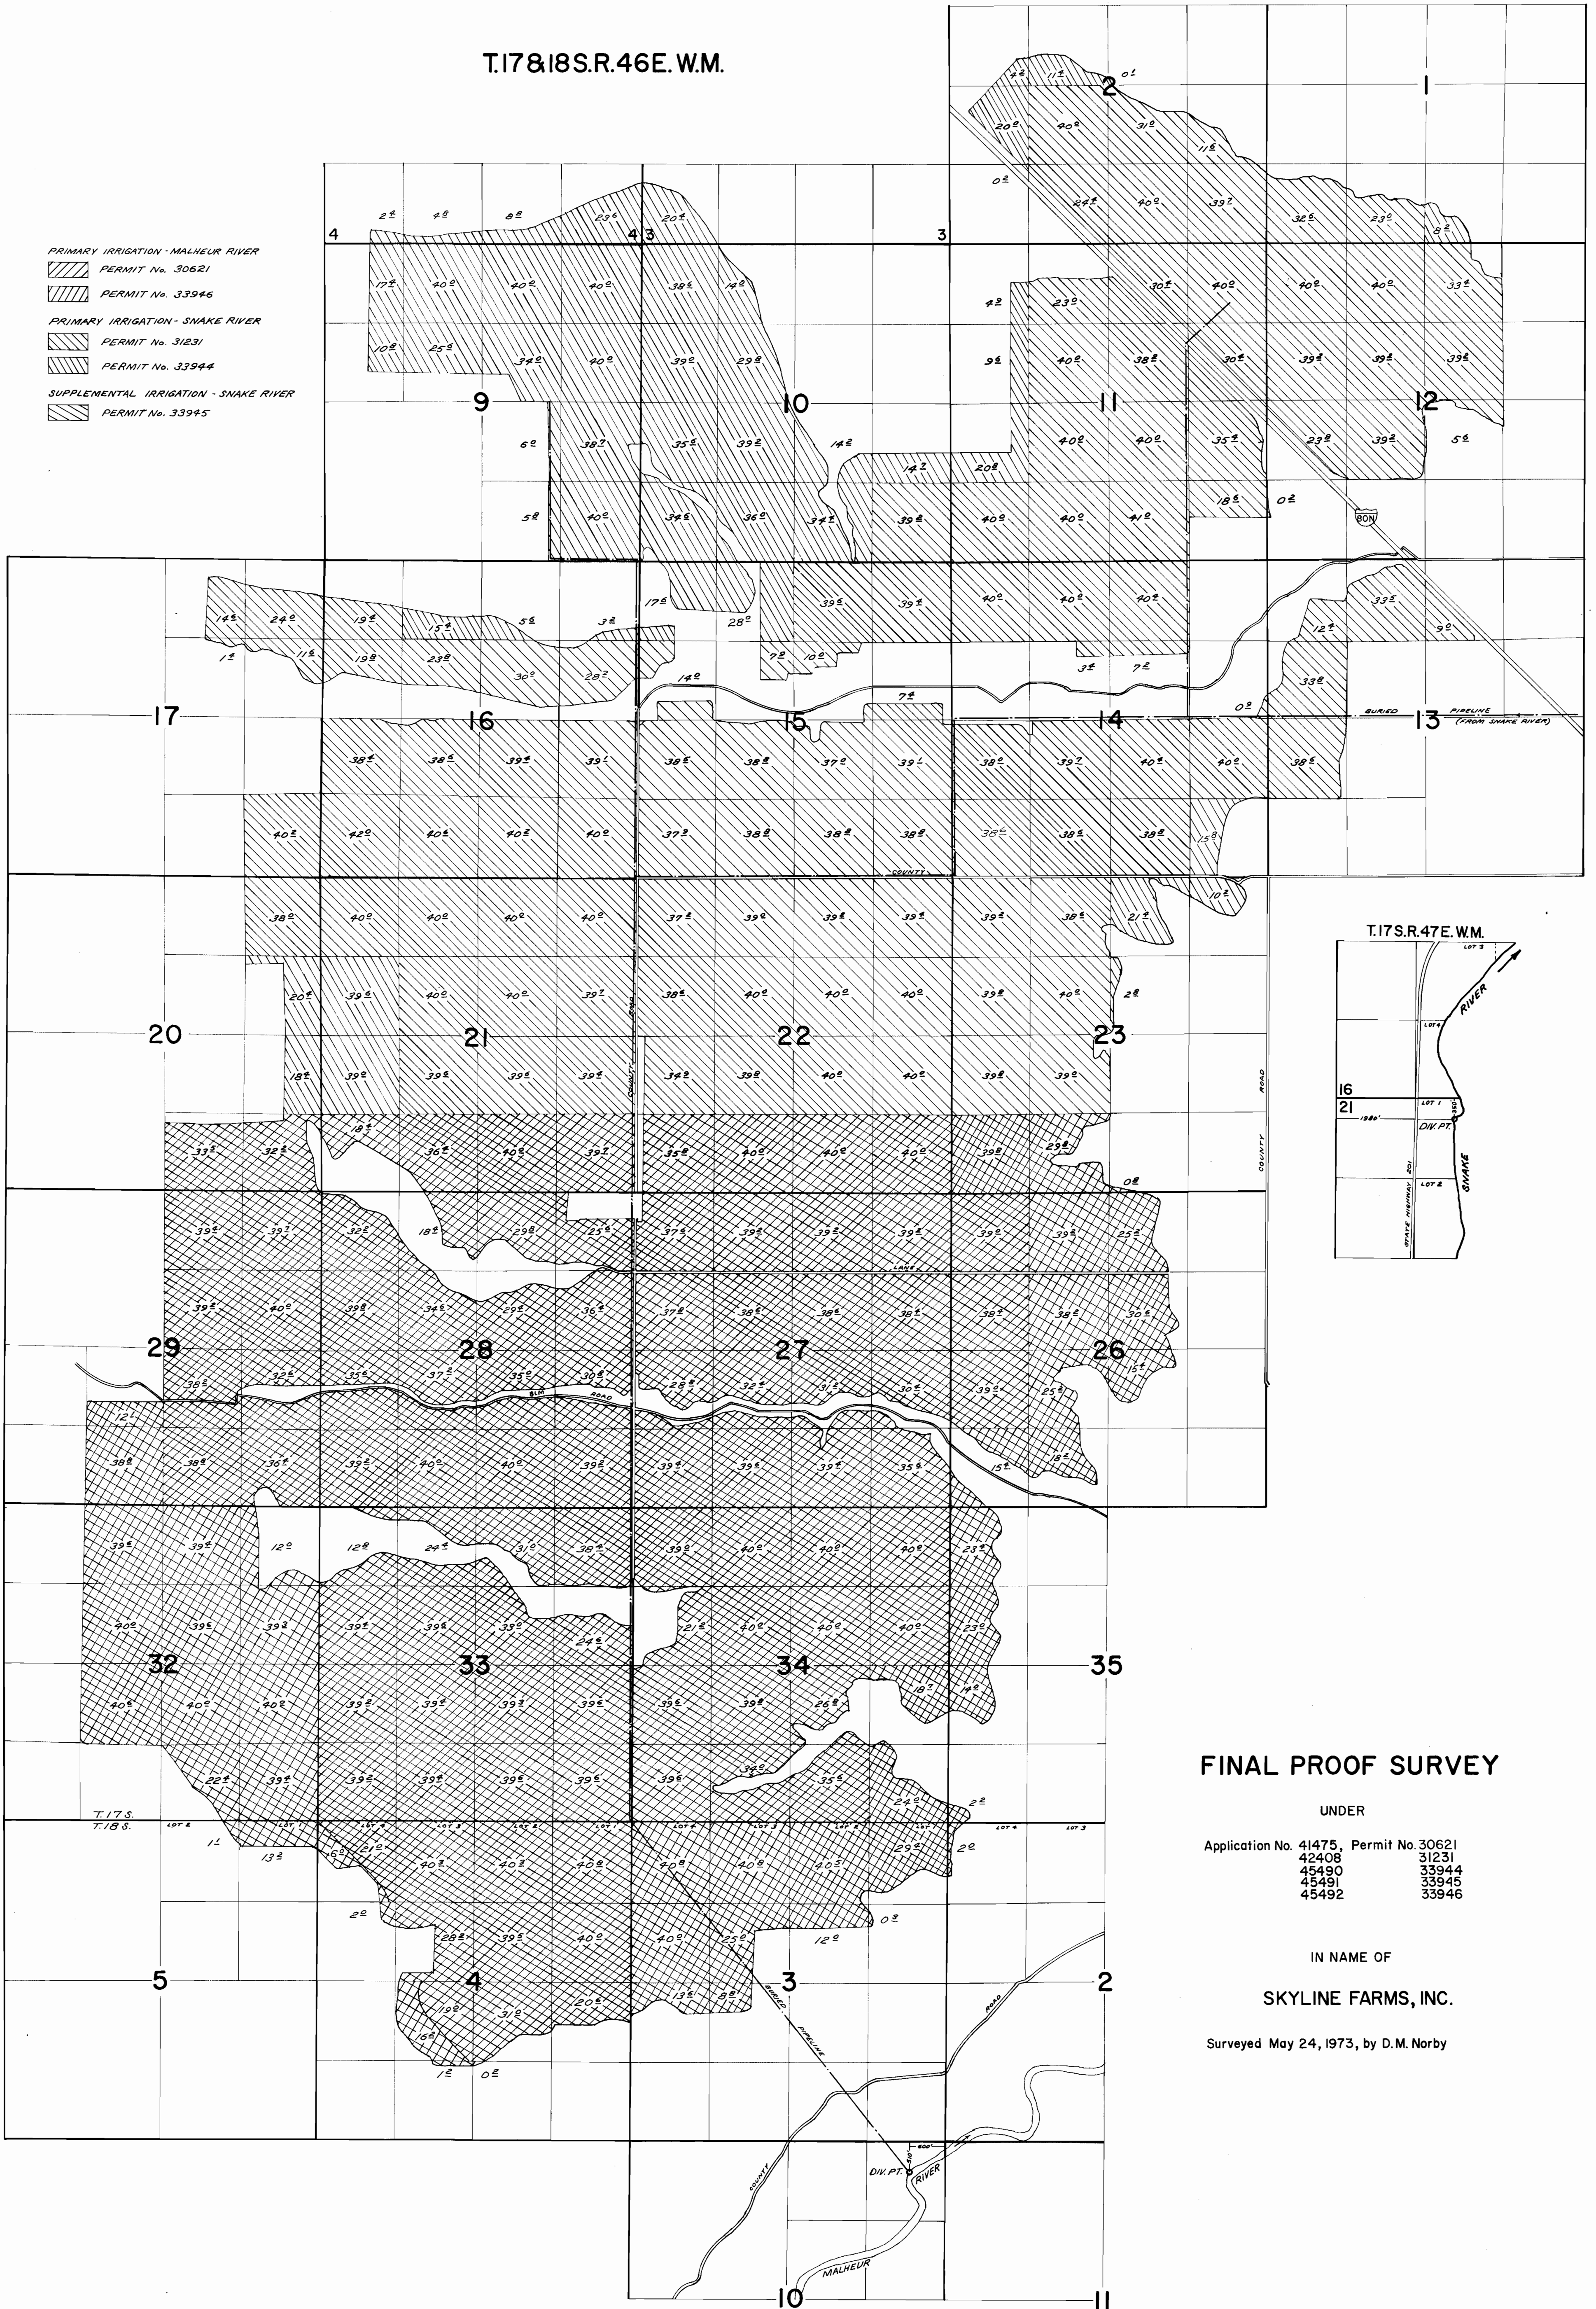

**FINAL PROOF SURVEY**

UNDER  
 Application No. 41475, Permit No. 30621  
 42408 31231  
 45490 33944  
 45491 33945  
 45492 33946

IN NAME OF  
**SKYLINE FARMS, INC.**  
 Surveyed May 24, 1973, by D.M. Norby