


T. 13 S., R. 8 E., W.M.

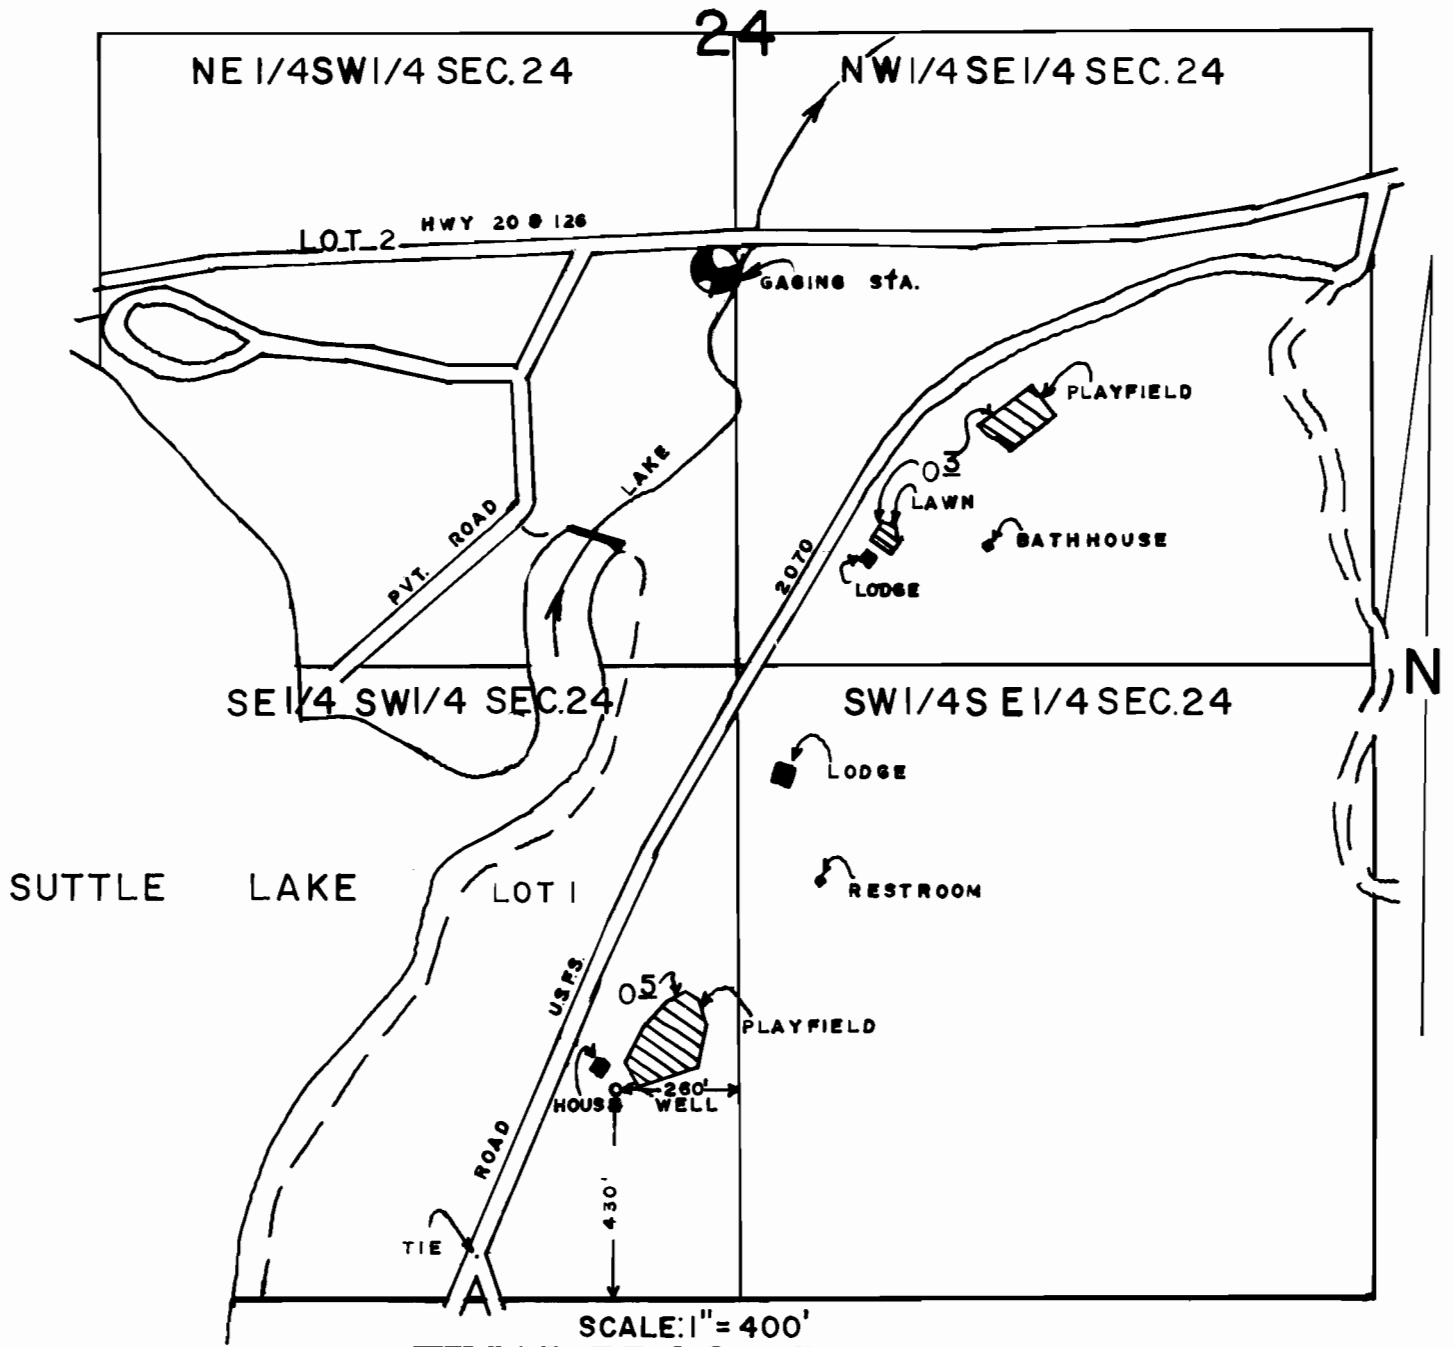

SCALE: 1" = 400' FINAL PROOF SURVEY UNDER

Application No. G-11518 Permit No. G-10875
IN NAME OF

SUTTLE LAKE UNITED METHODIST CAMP

Surveyed DEC 27, 1991, by B.W. BISHOP