


T.38S.,R.40&41E.,W.M.

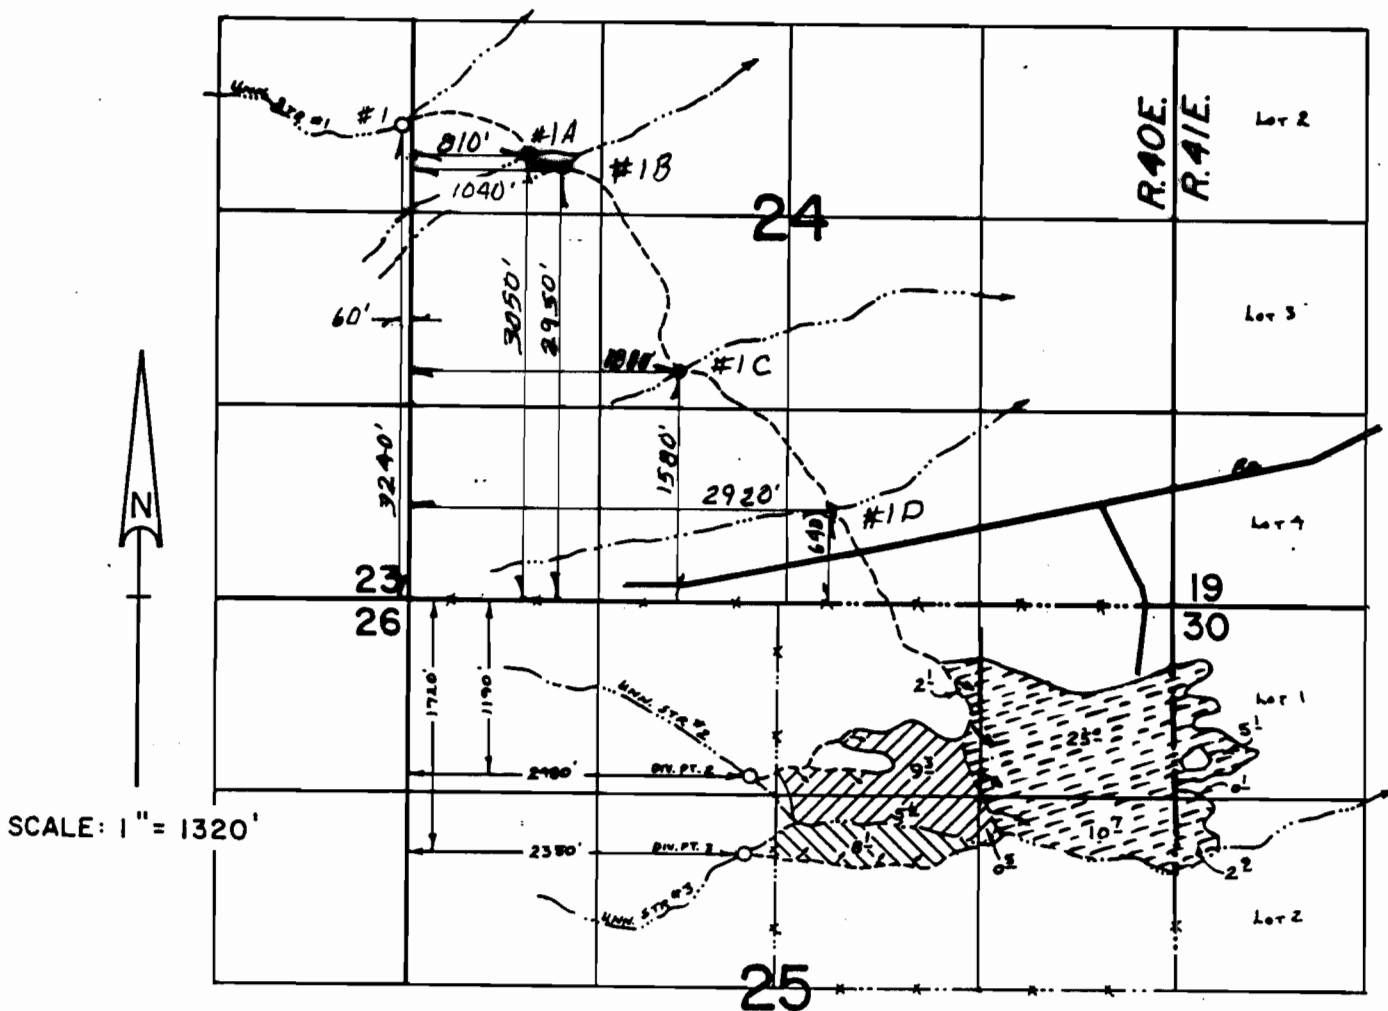

from Unnamed Stream No. 2  
from Unnamed Stream No. 3

*This application*

Application No. 42139 Permit No. 31513  
IN NAME OF

JOHN STODDART

Surveyed July 25, 1985, by J. M. TOLL

**FINAL PROOF SURVEY**  
UNDER

Application No. 69662 Permit No. 52302...  
IN NAME OF

Richard and Jeanette Yturriondabeitia

THIS MAP WAS PREPARED FOR THE  
PURPOSE OF IDENTIFYING THE LOCA-  
TION OF A WATER RIGHT ONLY AND IS  
NOT INTENDED TO PROVIDE LEGAL  
DIMENSIONS OR LOCATION OF PROPER-  
TY OWNERSHIP LINES.

Inspected June 23, 2000 by

