


# T. 9 S., R. 16 E., W.M.

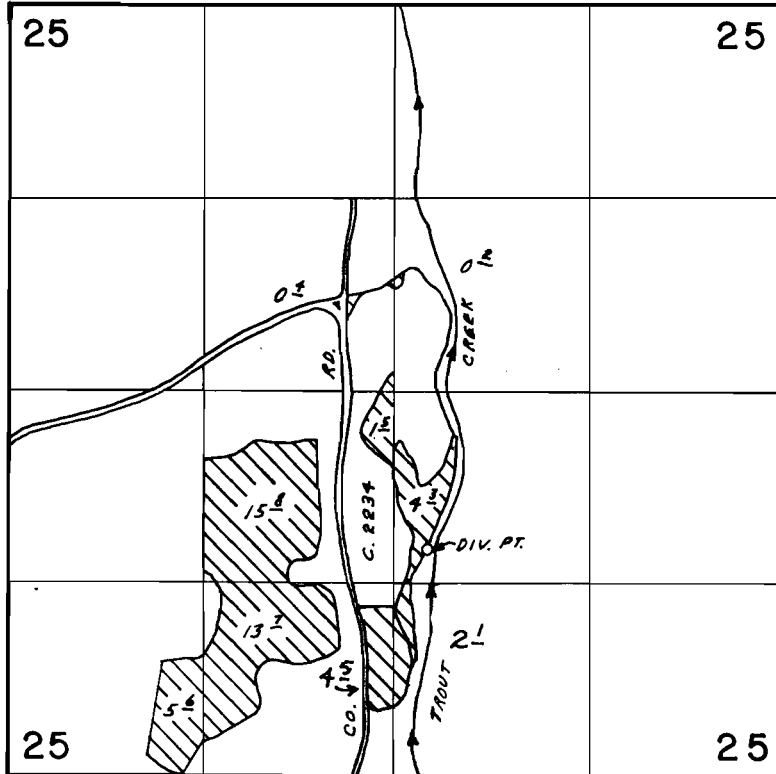

DIV. PT. LOC: 220' N. & 230' E FROM NW COR. OF SW 1/4 SE 1/4 SEC. 25

SCALE: 1" = 1320'

## FINAL PROOF SURVEY UNDER

TRANSFER 3690  
Application No. 55999 Permit No. 42196..... C. 76962  
IN NAME OF

JIM NARTZ

Surveyed AUG. 18, 1988, by B. BISHOP.....