


T. 4S., R. 13 & 14E., W.M.

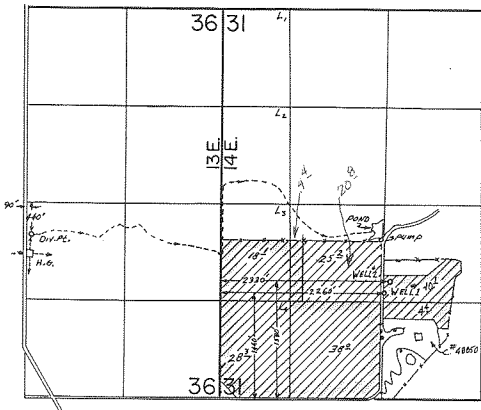

Scale : 1" = 1320'

**FINAL PROOF SURVEY**  
UNDER

for Cert 76792  
(post HB 3111)

103 Primary  
20 Supplemental

Application No. G-7219... Permit No. G-6746.....  
IN NAME OF

VERL E. FLEISCHMAN.....

Surveyed Sept. 10, 1979, by G.R. RODRIGUEZ.