


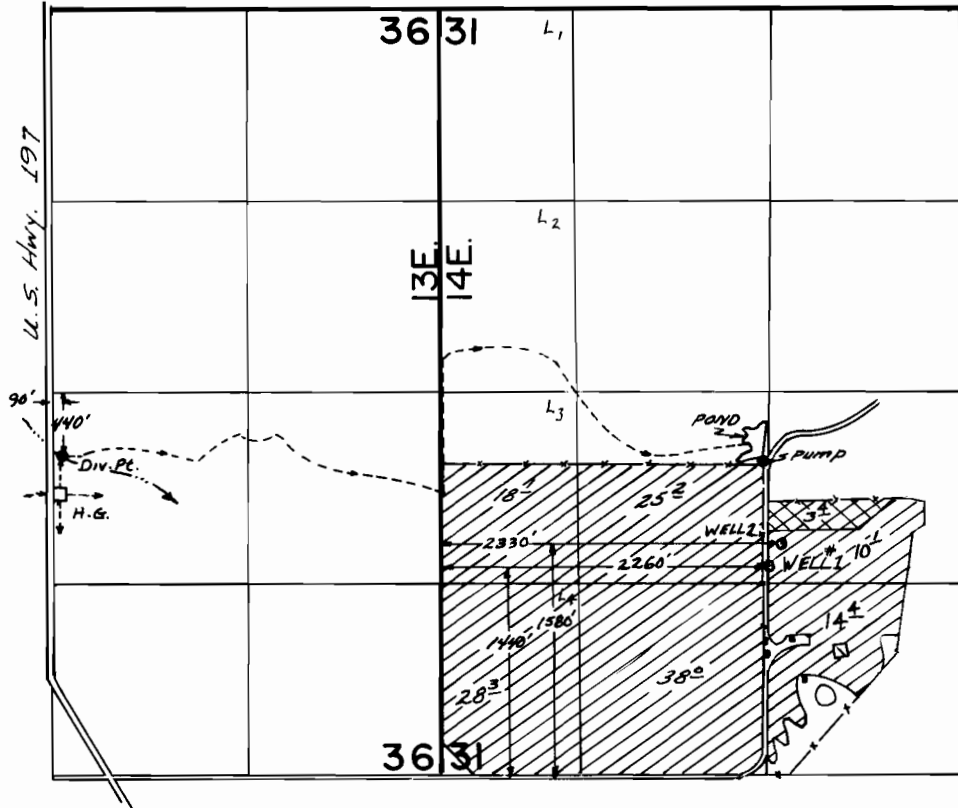

T. 4S. R. 13&14E. W.M.



-  - Primary; PERMIT G-7403, SUPPLEMENTAL; PERMIT 41039
-  - SUPPL.; PERMITS G-7403 + 41039

Scale: 1" = 1320'
FINAL PROOF SURVEY
 UNDER

54700 41039
 Application No. ~~G-7973~~ Permit No. ~~G-7403...~~
 IN NAME OF

.....**VERL E. FLEISCHMAN**.....

Surveyed Sept. 10.. 1979., by C.R. RODRIGUEZ.