


T.5S.,R.12E.,W.M.

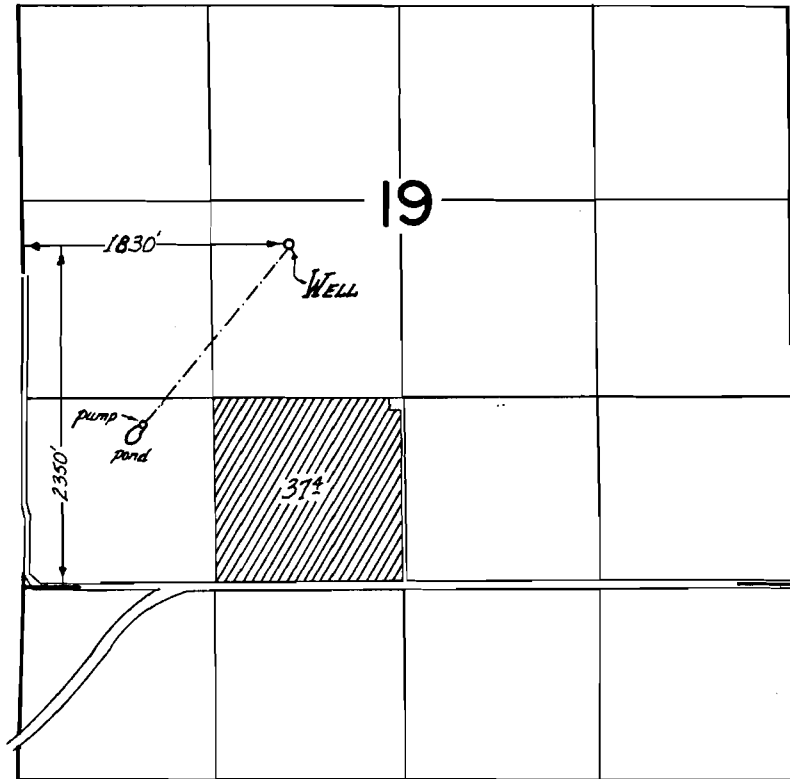

FINAL PROOF SURVEY UNDER

Application No. G-5499 Permit No. G-5398
IN NAME OF

ARCHIE J. MANGUM & MARY MANGUM

Surveyed June 23 1977, by R.G. Mucken

g 5398
372-122 *AR*