


RECEIVED

SEP 16 1996

WATER RESOURCES DEPT.
SALEM, OREGON

T. 14S., R. 39E., W.M.

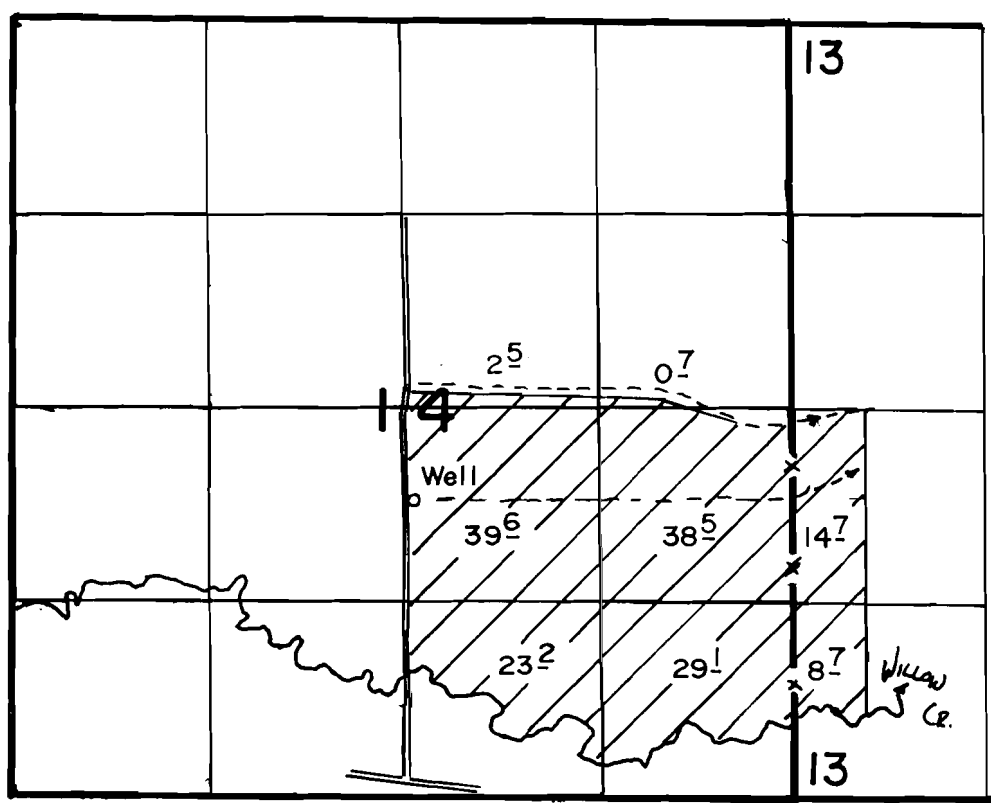

Scale 1" = 1320'

Well loc: 2040'N. and 2580'W. from SE cor. Section 14

FINAL PROOF SURVEY UNDER

Appl. G-12590

Per. G-11713

IN NAME OF

RESERVOIR LAND COMPANY OF ORE., INC.

SURVEYED AUGUST 31, 1996

The purpose of this map is for identifying the location of the water right only and is not intended to provide legal dimensions of property ownership lines

