

RECEIVED

OCT - 2 1997

WATER RESOURCES DEPT.
SALEM, OREGON

SEE EXHIBIT "A"

DP = DIVERSION POINT

2177'± NORTH, 700'± WEST 1/4 SECTION 7 & 8

D = DAM

2 1/2 X 2 1/2 CONCRETE DAM


R = RESERVOIR

8' X 8' X 4' CONCRETE BLOCK

M = METER

SENSUS METER

P = PIPELINE

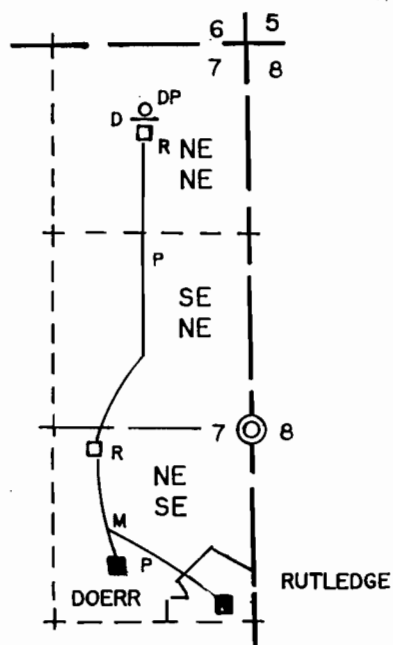

THE PREPARATION OF THIS MAP WAS FOR THE PURPOSE OF
IDENTIFYING THE LOCATION OF THE PROPOSED WATER RIGHT AND HAS
NO INTENT TO PROVIDE DEMENSIONS OR LOCATION OF PROPERTY
LINES.

T 34 S, R 11 W, W.M.,
SECTION 7
FINAL PROOF SURVEY

UNDER

APPLICATION #74043 PERMIT #52085

IN THE NAME OF

ROBERT P. DOERR

SURVEYED MARCH 20, 1997 BY H.J. NEWHOUSE

SCALE 1" = 1320'

