


FEB 28 2000

WATER RESOURCES DEPT.
SALEM, OREGON

SECTION 27, T.2 N., R.4 W., W.M.
WASHINGTON COUNTY, OREGON

MAP BASE:
7-20-98 SCALED PHOTO
ASSESSORS MAP

PREPARATION OF THIS MAP IS FOR THE
PURPOSE OF IDENTIFYING THE LOCATION OF
THE WATER RIGHT ONLY. THERE IS NO INTENT
TO PROVIDE DIMENSIONS OR LOCATION OF
PROPERTY OWNERSHIP LINES.

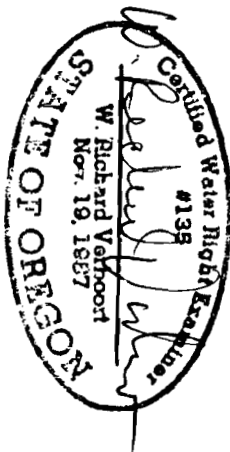

T.L. 402

POND #3

SEDIMENT
POND


POND #2

POND #1

FINAL PROOF SURVEY

UNDER
APPLICATION PERMIT
S-74416 52264
R-74417 R-11800
SURVEYED FEBRUARY 12, 2000

SCALE: 1" = 400'

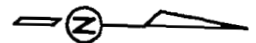

2475'

2440'

1910'

2520'

1460'
1580'
1710'
1740'

28 27
35 34

N.W. NARUP ROAD

N.W. KILLIN ROAD

VERBOORT ENGINEERING

AGRICULTURE • CIVIL • WATER RESOURCES
HILLSBORO, OREGON

designed by WRY 02/19/00
drawn by JR 02/19/00
checked by WRY 02/19/00
drawing no. 00-A-01
sheet no. 1 / 1

DAVID A. and JUDITH R.
MADSEN

14405 N.W. KILLIN ROAD
BANKS, OR 97106