


T. 1 N., R. 13 E., W.M.

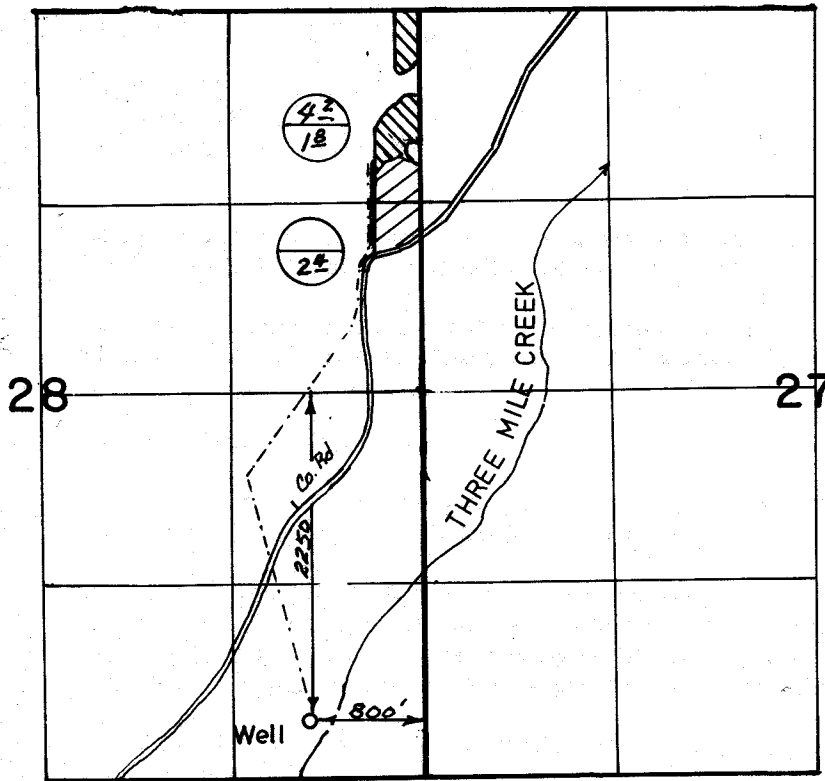

 PRIMARY
SUPPLEMENTAL

FINAL PROOF SURVEY

UNDER

Application No. G-10912 Permit No. G-10127
IN NAME OF

J. T. PHETTEPLACE

Surveyed 2-6, 1992, by J. MILLER

41065-179-135L

Revised 9/22/00 *JMB*