


RECEIVED

MAR 19 1997

WATER RESOURCES DEPT.
SALEM, OREGON

Note: This map is for the purpose
of identifying the location of the
water right only and is not intended
to provide legal dimensions or location
of property ownership lines.

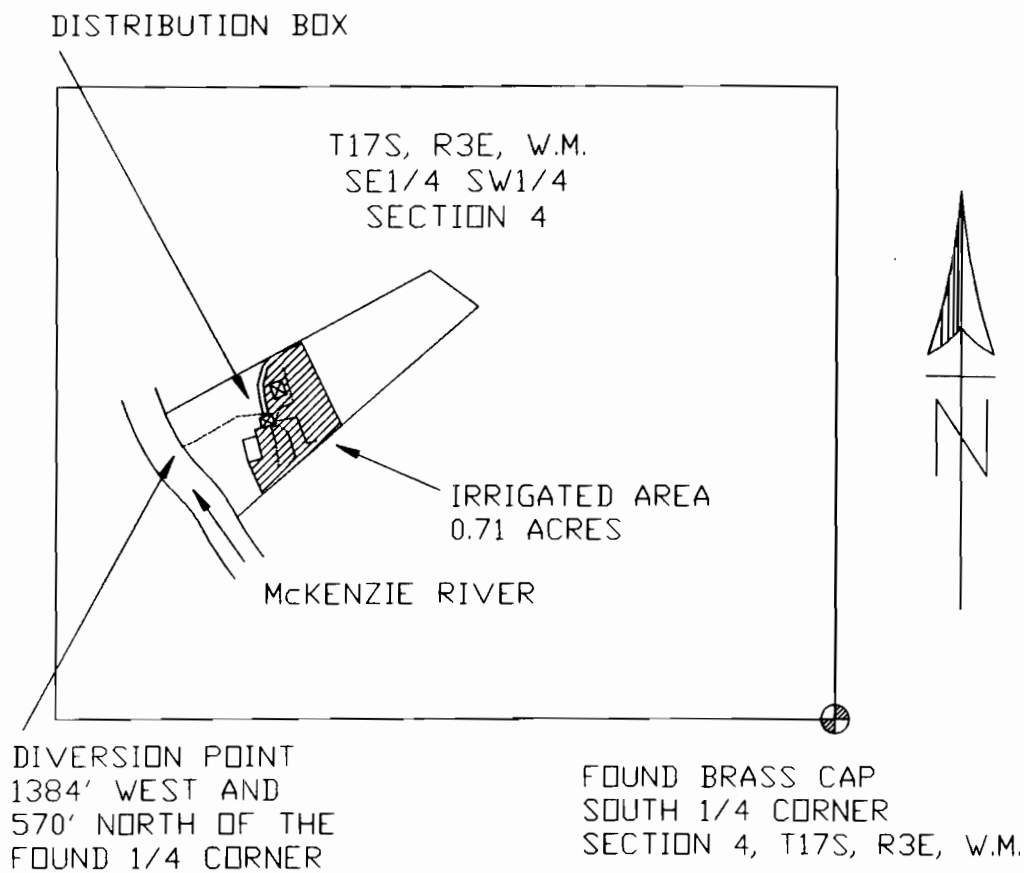

BURIED 1-1/2" WATERLINE
FROM DIVERSION POINT
TO DISTRIBUTION BOX.
3/4" FROM DISTRIBUTION
BOX TO HEADS.

SCALE 1" = 400'

FINAL PROOF SURVEY

UNDER

APPLICATION NO. 71820 PERMIT NO. 51639

IN THE NAME OF

RUTH M. SKAAR

SURVEYED NOVEMBER 10, 1996

