
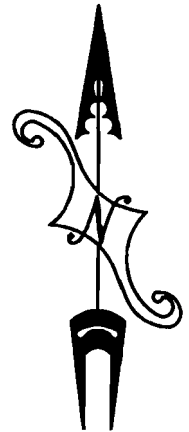


T. 4S., R. 3W., W.M.

21


22

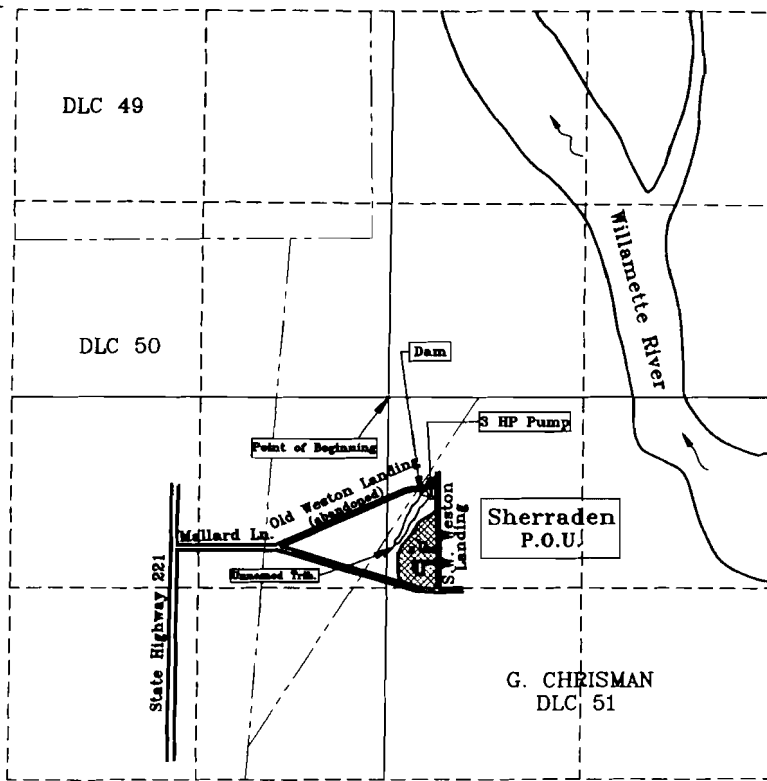

SCALE: 4" = 1 MILE

NOTES:

1. DAM AND P.O.D. LOCATIONS ARE 550 FT. S. AND 250 FT. E. FROM THE N.W. CORNER OF SECTION 27.
2. THE WELL AND PUMPHOUSE ARE 800 FT. S. AND 130 FT. E. FROM THE N.W. CORNER OF SECTION 27. (POINT OF BEGINNING)
3. THE 3 HP PUMP SUPPLIES WATER VIA A 1-1/4" DIAMETER PLOYETHYLENE PIPE APPROXIMATELY 300' TO A BURIED 1" DIA. PVC DISTRIBUTION SYSTEM.
4. THE PURPOSE OF THIS MAP IS TO IDENTIFY THE LOCATION OF THE WATER RIGHT. THE MAP IS NOT INTENDED TO PROVIDE INFORMATION RELATIVE TO THE LOCATION OF PROPERTY OWNERSHIP BOUNDARY LINES.

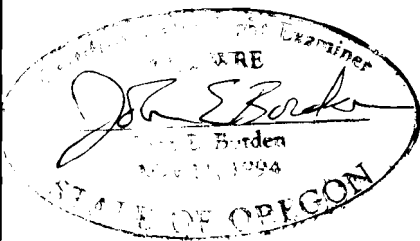

PRIMARY USE FOR SHERRADEN

FINAL PROOF SURVEY

UNDER

APPLICATION NUMBER: S-74694 PERMIT NUMBER: 52137

IN THE NAME OF:

Kenneth W. Sherraden

SURVEYED JUNE 7, 1997, BY JOHN E. BORDEN

JOHN BORDEN CONSULTING

PHONE: (503) 393-8736

Sherraden Water Right